


Midship Section

S.S. No 525

S.S. "Unfuli"
Sunderland Report No 17162

Dimensions 300'-0" P.P. x 40'-0" x 24'-2" Mold

Scale 1/2 inch = to 1 Foot
If Web frames fitted

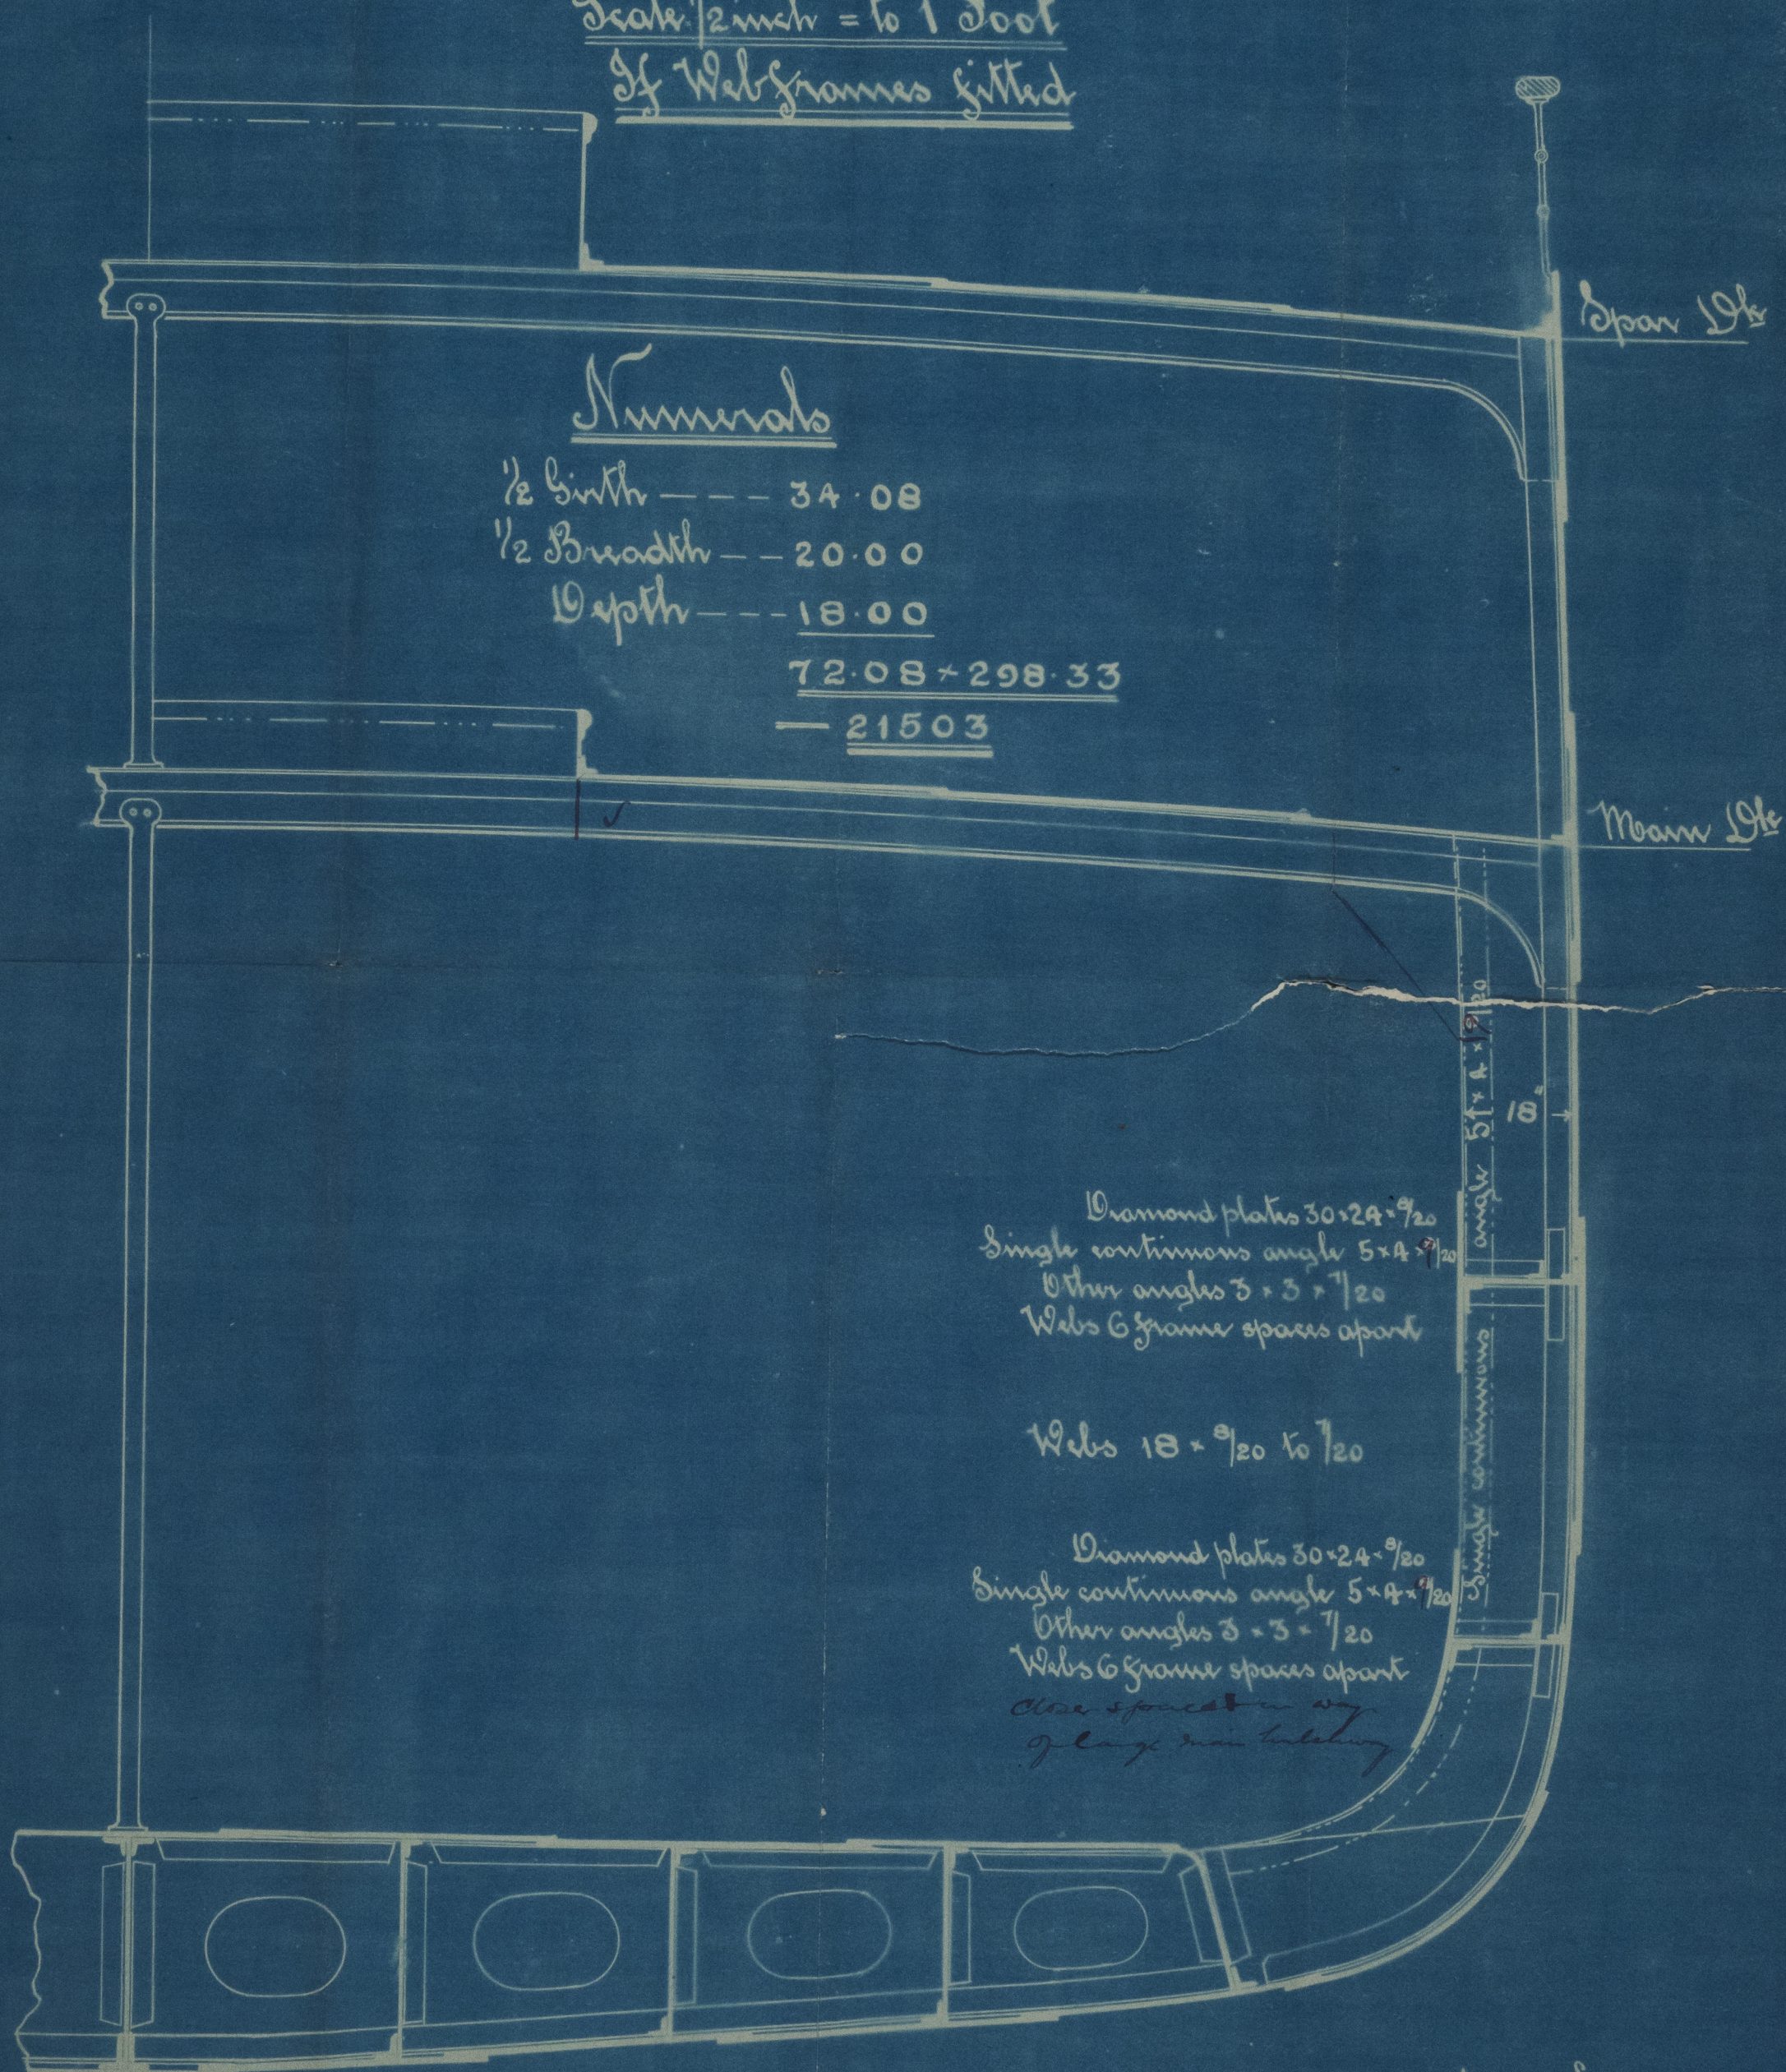


1/2 Birth --- 34.08

1/2 Breadth --- 20.00

Depth --- 18.00

72.08 x 298.33

— 21503


Single continuous angle 5 x 4 x 7/20
Other angles 3 x 3 x 7/20
Web 6 frame spaces apart

Web 18 x 9/20 to 7/20

Other angles 3 x 3 x 7/20
Web 6 frame spaces apart
close spaced in way
of long run tubing

James Laing
Deptford Yards
Sunderland



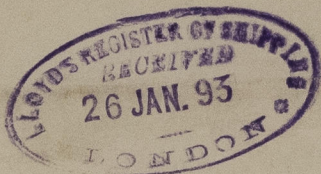

J. LAING'S

— S.S. No 525 —


MIDSHIP SECTION

Showing web frames.

F. S. Unifoli

Sunderland Report

No 17162

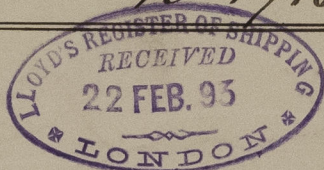

© 2021

Lloyd's Register
Foundation

SLD988-0186