

*Lib 7/3/93.
25.9.93*

Hold Sections	
No 1 Hold	2 1/2
No 2 do	2 2
Eng + Blr space in well	2 2 1/2
do do	1 4
After peak	
Tunnel Recess	1 3
Hold well	


*Loamage U D
2687 tons
P.L.*

*S. S. No 525
Pumps + Section Arrangement
Scale 1/16 inch equals 1 foot*

*S.S. 'Unifoli'
Sunderland Report
11/17/62*

Tank Sections	
Don peak tank	1 3/2
No 1 Ballast tank	1 3
No 2 do do Wings	2 2 1/2
No 2 do do Centre	1 4
Tanks under Eng. Blr King	2 2 1/2
do do Centre	1 3 1/2
No 3 tank	Wing 2 2 1/2
No 3 do	Centre 1 4

Hand Pumps	
No 1 Hold	1 5 inch
No 2 do	2 do
Eng + Blr space	1 do
No 3 Hold	1 do

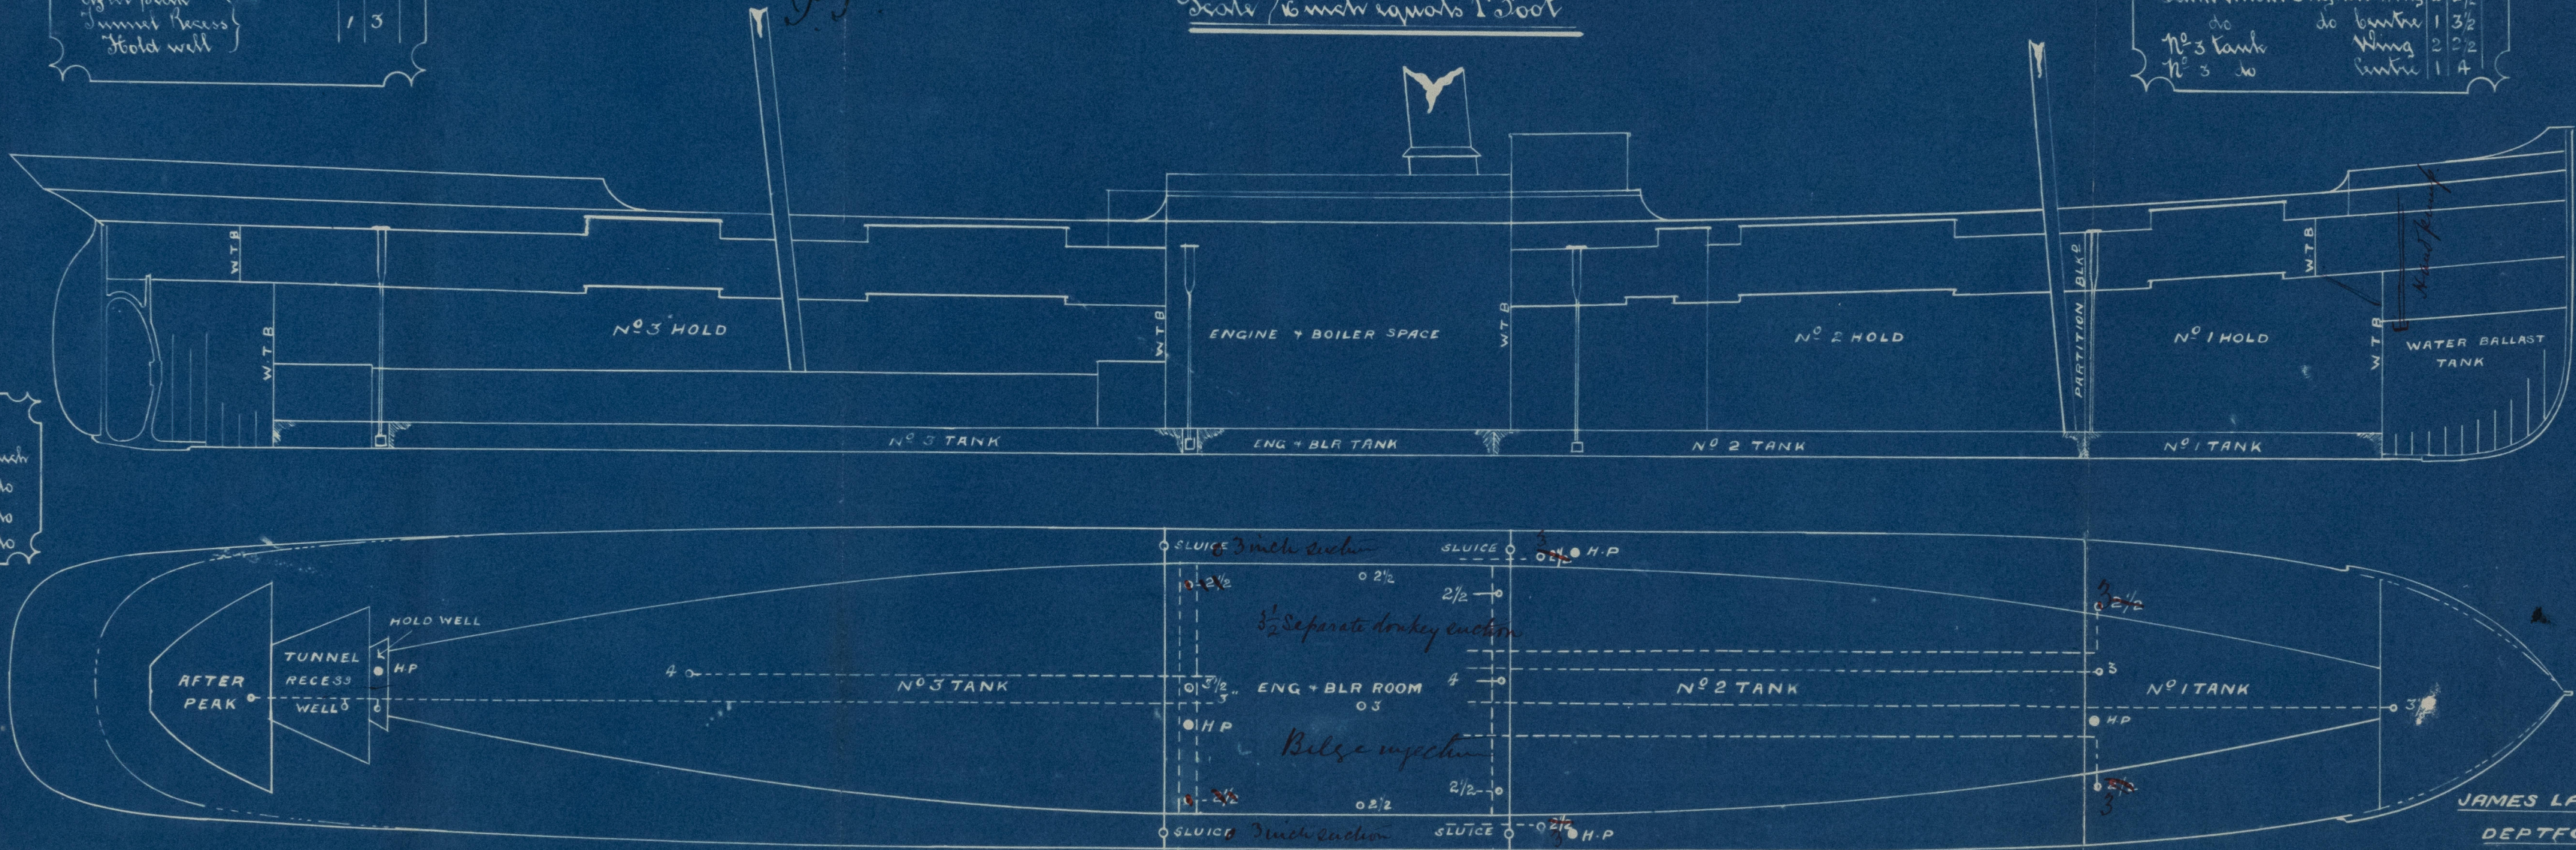

Sluices accessible

*William S. Shanks
P.L.*



SLD 988 - 0192

Lamigo No 5-25
Pumping plan
S. S. Lamiguli
Sunderland Report
No 17162



© 2021

Lloyd's Register
Foundation

SLD988 - 0192