
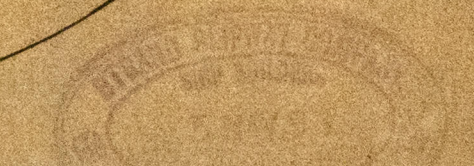
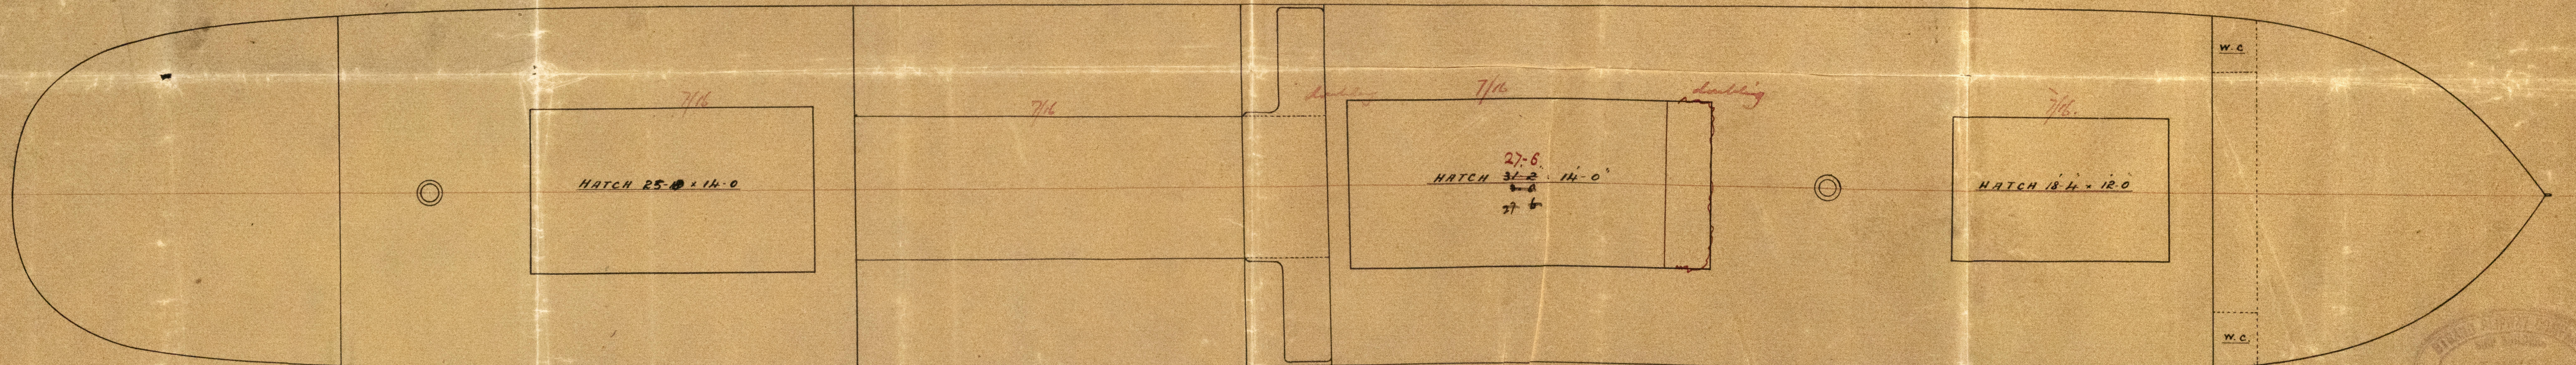


12.5.93

BEAM ARRANGEMENT FOR N° 90 S.S.

Scale $\frac{1}{8}$ " = 1 Foot.

"Mimi"
S/L Rpt. No. 17171.



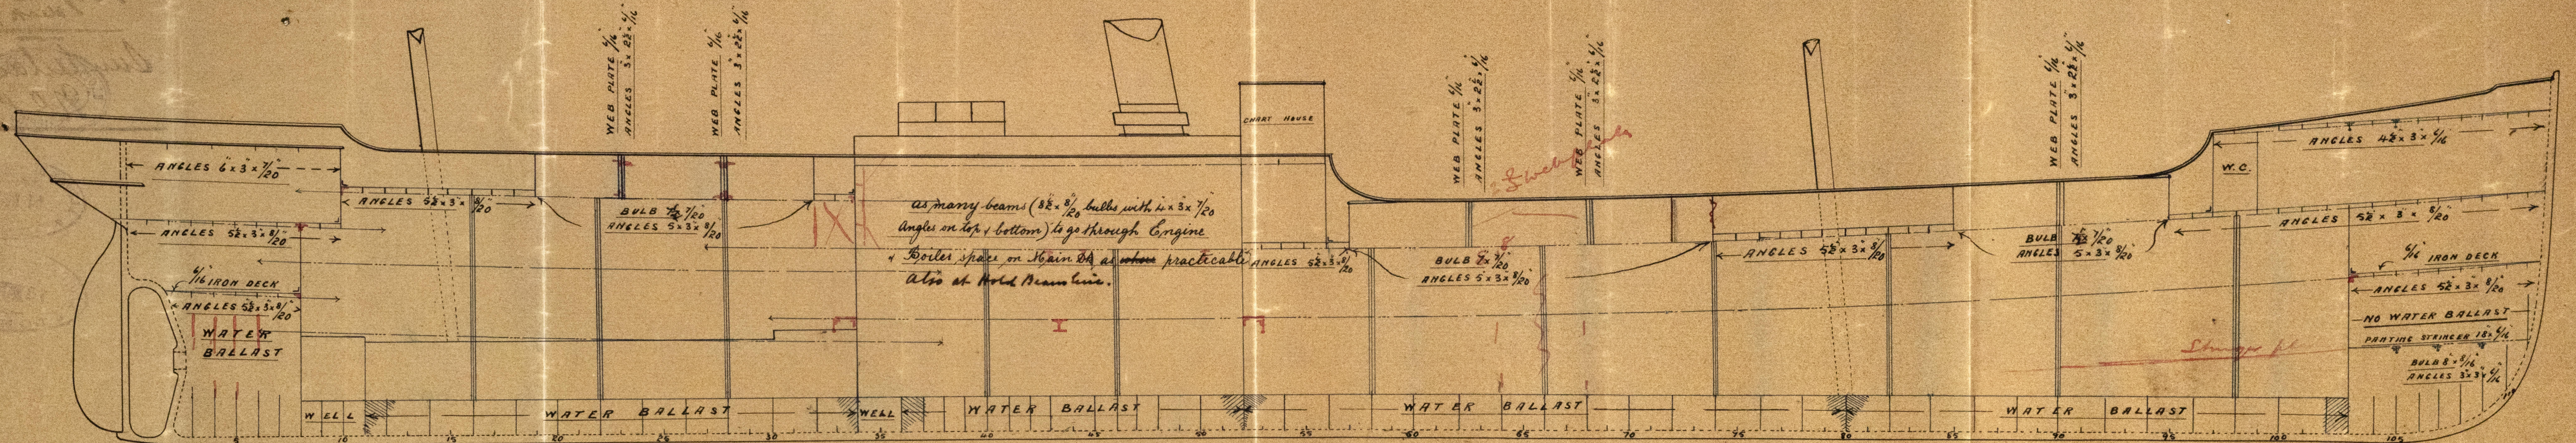


EP 2 11

"Mimi"
Revised 17/70.
Strand Shipway
Company
No. 90

Proprietary
deck plan.

Inspected Report
No. 111/1

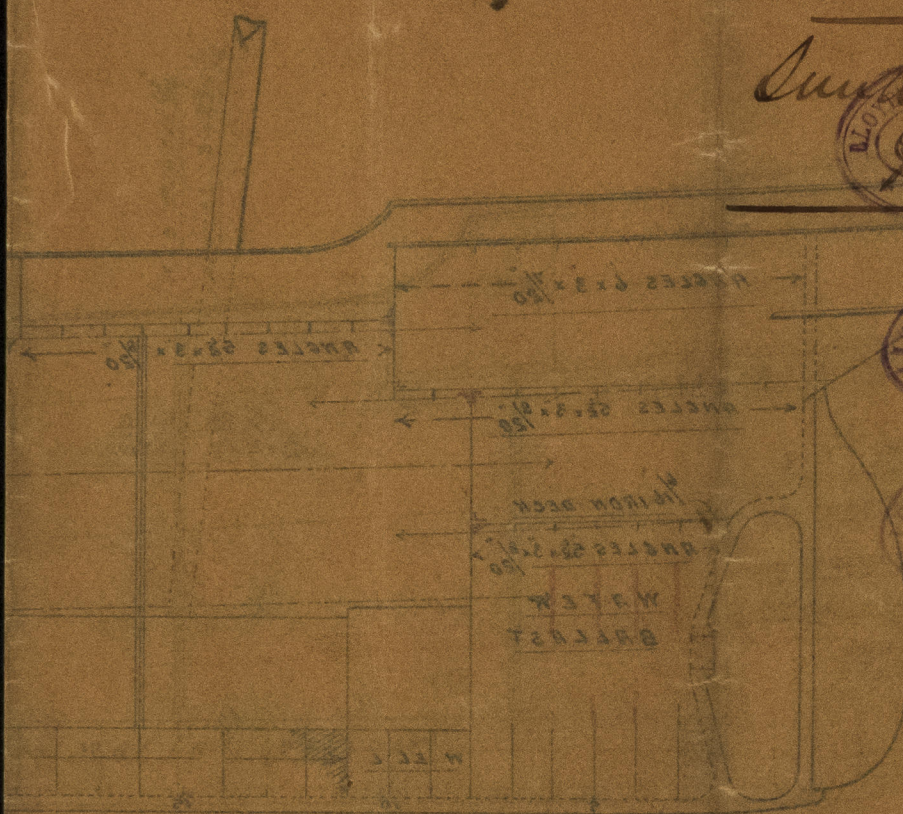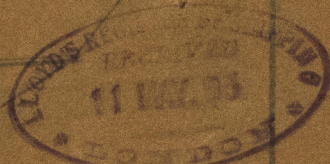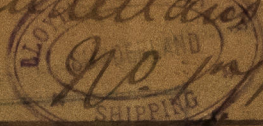

9000-686475



© 2021

Lloyd's Register
Foundation