

## Lloyd's Register of British and Foreign Shipping.

(Report on Vessel No. 17171 Port SUNDERLAND)*Sunder*  
No. 2540 a

## SHIP FORGINGS OR CASTINGS.

I have to report that the undermentioned Iron ~~or Steel~~ Forgings ~~or Castings~~,  
 manufactured by *Mr Tho Ray*  
 of *Paltion* for the Vessel No. *90*, being built  
 by *The Strand Shipway Co* of *Sunderland*  
 have been inspected by me as set forth below, and found to be, so far as can be seen,  
*sound*

Mark on Forgings.

Lloyd's


No. 2540 a.

*Hugh Cameron**Sunderland*

10-8-93

	STERN FRAME.	RUDDER FRAME.	STEM.
Material*	<i>Scrap iron</i>	<i>scrap iron</i>	<i>scrap iron</i>
How made	<i>Forged</i>	<i>Forged</i>	<i>Forged</i>
Dimensions	<i>7' x 4 3/4'</i>	<i>5' - 3'</i>	<i>7' x 2 1/4'</i>
Progress on Inspection	<i>Forged &amp; milled</i>	<i>Forged &amp; milled</i>	<i>Forged</i>
Date when Inspected	<i>May 27<sup>th</sup> to June 12/93</i>	<i>June 30 July 15/93</i>	<i>June 30/93</i>

SKETCHES OF FRAMES SHOWING POSITION AND DESCRIPTION OF WELDS OF FORGINGS, OR PARTICULARS OF  
 TESTS APPLIED TO CASTINGS.

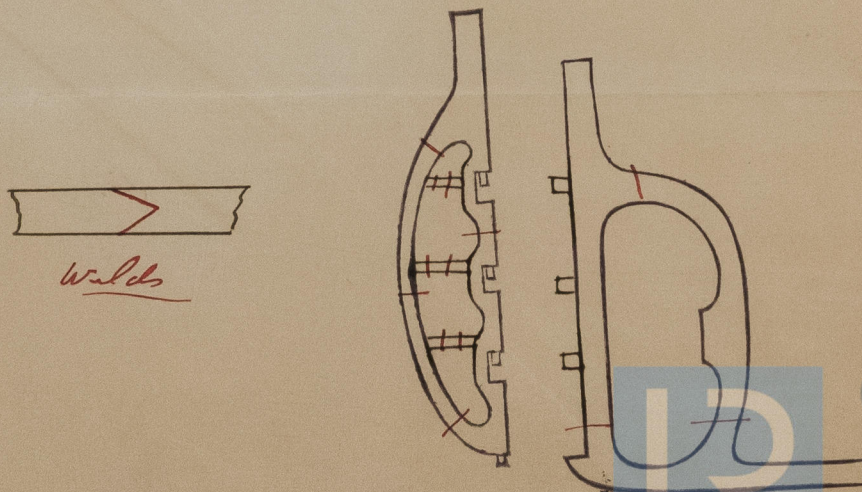

\* If of Iron, state whether scrap or puddled Iron.