

# Lloyd's Register of British and Foreign Shipping.

*Sound*

(Report on Vessel No. 14.294 Port SUNDERLAND.)

No. 2577a

## SHIP FORGINGS OR CASTINGS.

The words FORGINGS or CASTINGS, IRON or STEEL, should be struck out as may be required.

I have to report that the undermentioned Iron ~~or Steel~~ Forgings or Castings, manufactured by The Sunderland Forge Co of Falton for the Vessel No. 156, being built by Mrs. Bartram Roswell Co. of Sunderland have been inspected by me as set forth below, and found to be, so far as can be seen, Sound

Mark on Forgings.

Lloyd's

No. 2577a  
No. 6


*Wm. Cameron*

*Sunderland*

13-11-93

	STERN FRAME.	RUDDER FRAME.	STEM.
Material* ... ..	<i>Scrap iron</i>	<i>scrap iron</i>	<i>scrap iron</i>
How made ... ..	<i>Forged</i>	<i>Forged</i>	<i>Forged</i>
Dimensions ... ..	<i>10' x 6'</i>	<i>8' - 4"</i>	<i>10' x 2 3/4</i>
Progress on Inspection	<i>Forged Smoothed</i>	<i>Forged Smoothed</i>	<i>Forged</i>
Date when Inspected	<i>July 26<sup>th</sup> to Aug 19/93</i>	<i>Sept 7<sup>th</sup> to Oct 30/93</i>	<i>Sept 7/93</i>

SKETCHES OF FRAMES SHOWING POSITION AND DESCRIPTION OF WELDS OF FORGINGS, OR PARTICULARS OF TESTS APPLIED TO CASTINGS.

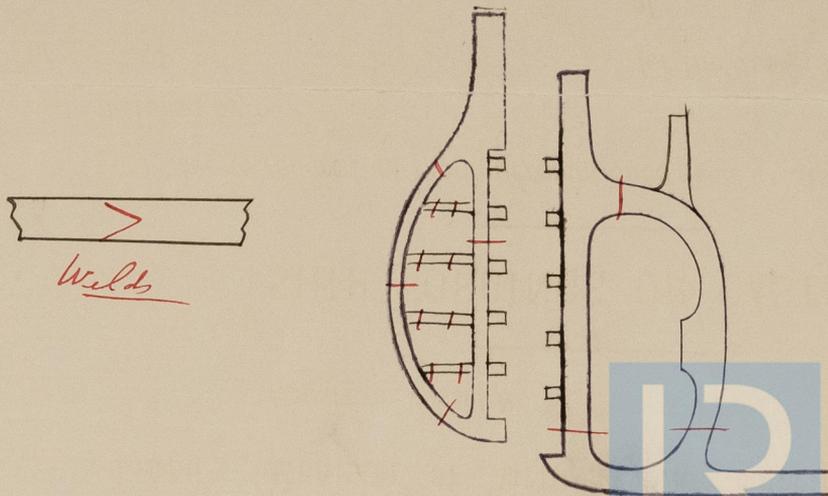

© 2021

Lloyd's Register Foundation