


BARTRAM HASWELL & CO.  
IRON & STEEL SHIPBUILDERS  
SOUTH DOCK,  
SUNDERLAND.


*Mr. 23.2.94.*  
*2.2. Kirkcaldy*  
*2.2. Kirkcaldy*

**WATER BALLAST SUNCTION ARRANGEMENT N<sup>o</sup> 156.**  
SCALE 1/8" = 1 FOOT.

UNDER DECK TONNAGE 2620

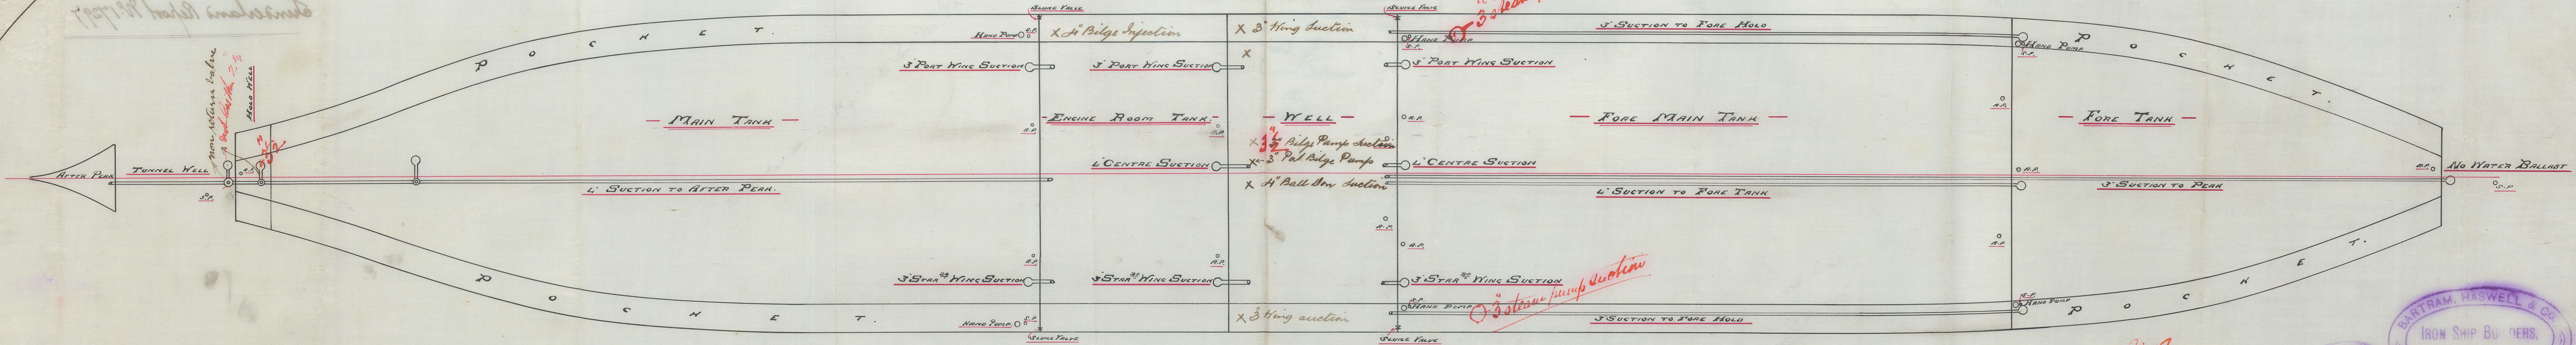

*N.A.*  
*20.2.94.*

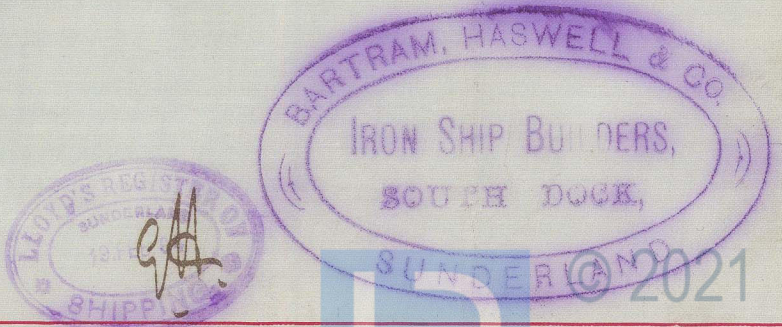

MESSRS  
BARTRAM HASWELL & CO


S. S. N<sup>o</sup> 156

Pumping Arrangements

S. S. "KIRKDALE"

Sunderland Report N<sup>o</sup> 17297

*W. D. S. 1887*

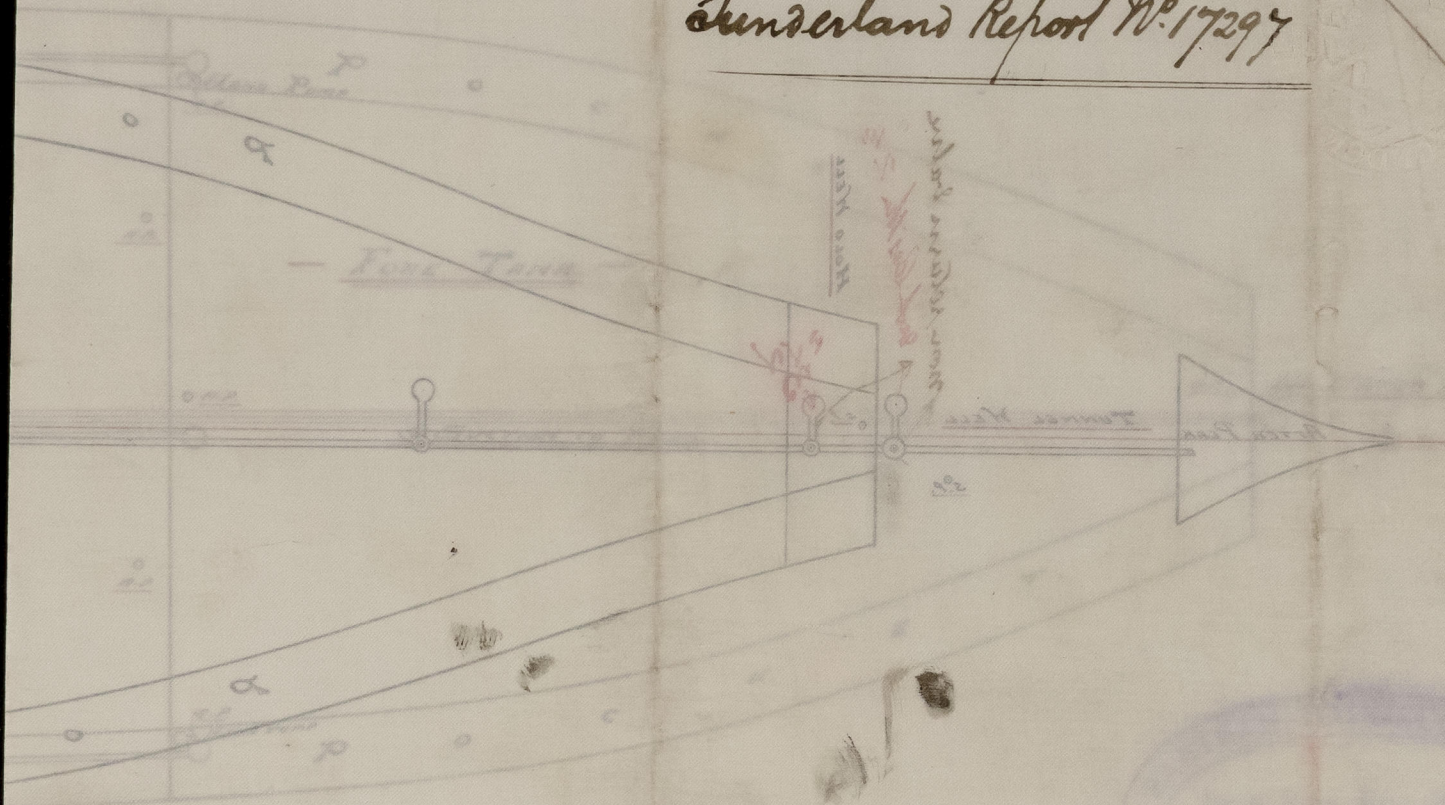

© 2021

Lloyd's Register  
Foundation