

No. 12  
Methu  
Date, 1912



94

X-2 If there is a division in the tank here  
than a Centre suction is required

PIPE PLAN N<sup>o</sup> 174.<sup>s/s</sup>.

UNDER DECK TONNAGE 2802.  
SCALE  $\frac{1}{2}$ " = 1 FOOT.

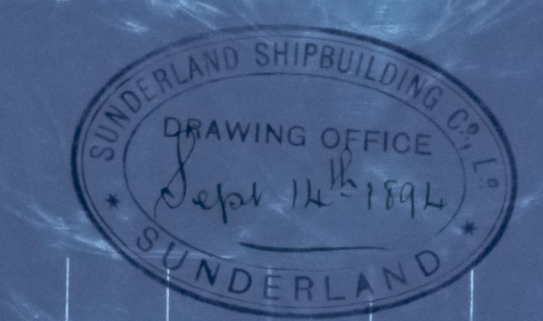

Main tank

Belgian injection to be fitted  
as per rule



P.S. 20-9-94



*\* If there is a division in the tank here then a Centre suction is required*

# PIPE PLAN No 174.5/s.

UNDER DECK TONNAGE 2802  
Scale 1" = 1 FOOT  
NO SLICE VALVES

 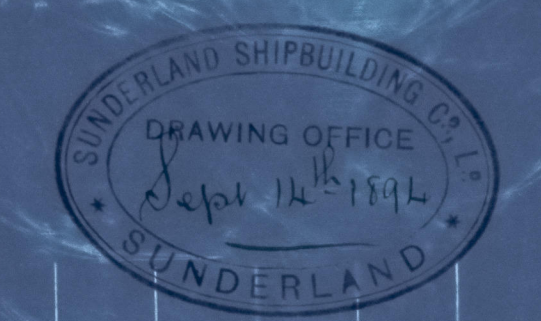

P.S. 20-9-94




560904-08250-1000725  
1/2 8250-1000725  
No. 10  
Encl  
Mefrs L  
Date, Se

SUNDERLAND SHIPBUILDING  
COS

— S.S. N<sup>o</sup> 174 —

PUMPING PLAN

---

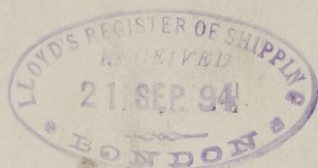

S. S. Merionethshire.

SUNDERLAND.

17645.



© 2021

Lloyd's Register  
SLD994-0128 1/2  
Foundation