


LENGTH B.P. 329 0
BREADTH M.L.D. 40 10
DEPTH TO MAIN DK FROM O.F. 20 0
SPAR DECK 7 6
CLASS. 100 R.I.

A circular postmark from Sunderland, dated Jan 16th/92. The text "SUNDERLAND" is visible at the top and bottom of the circle, and "JAN 16th/92" is written in the center.

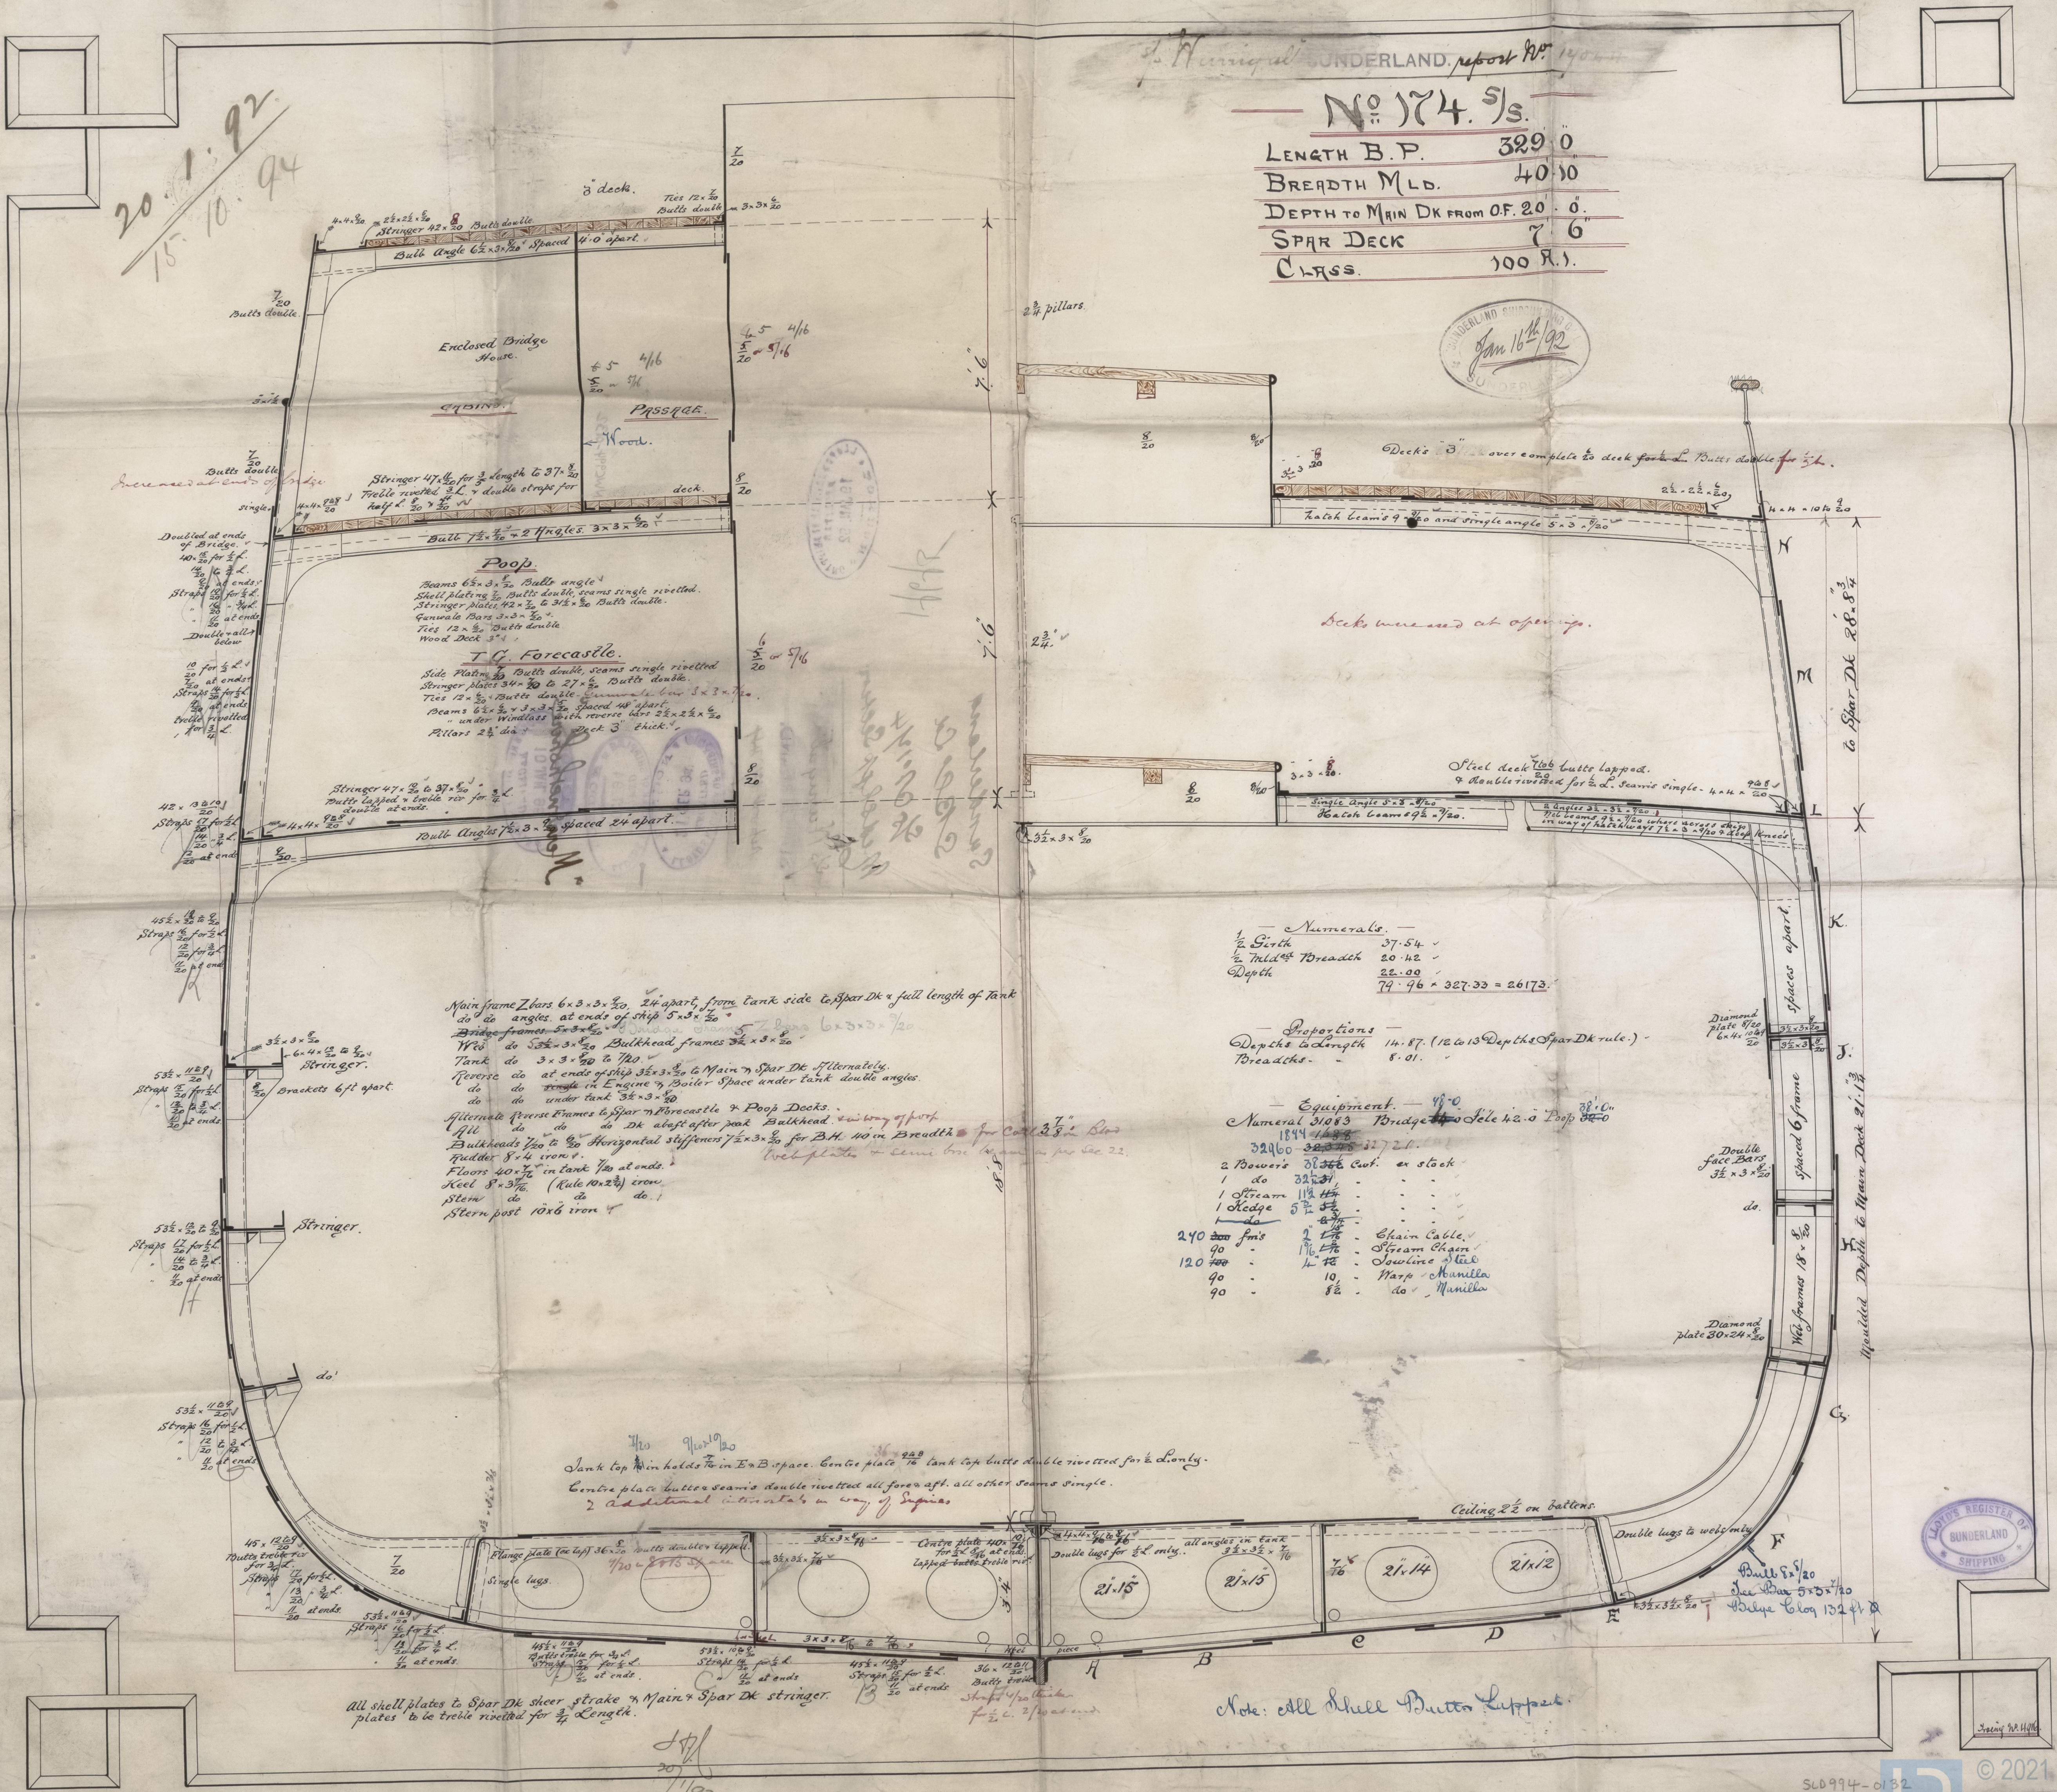

— Numerals. —		
$\frac{1}{2}$ Sixth	37.54	✓
$\frac{1}{2}$ Middle Breadth	20.42	✓
Depth	<u>22.00</u>	✓
	79.46	× 327.33 = 26173.

— Proportions —
 Depths to Length 14. 87. (12 to 13 Depths Spar Dk rule.)
 Breadths. " 8. 01. ✓

	- Equipment.	\$8'00	
	Numerical 51083	Bridge	\$2.50
	1894	1898	
	32460	32478	32721.
2 Boverie	32466	Cut.	ex stock
1 do	32471	"	"
1 Stream	113	"	"
1 Kedge	52	"	"
1 do	53	"	"
200 fms	2	Lt	Chain Cable.
40 -	16	Lt	Stream Chain
400 -	4	TG	Dowling lead
40 -	10,	Marp	Manilla
40 -	82	do	Manilla

This image shows a blank, aged, cream-colored page, likely an endpaper or flyleaf of a book. The paper has a slightly textured appearance with some minor discoloration and small dark spots, possibly due to age or handling. The right edge of the page shows the binding of the book, with visible stitching and the edge of the next page.

Ceiling $2\frac{1}{2}$ on battens.

16

21' x 15'

21' x 14'

21' x 12'

k.35

A diagram of a horizontal beam with a fulcrum in the center. A weight is suspended from the left end, and another weight is placed on the right end. The beam is labeled with 'c' on the left, 'D' on the right, and 'E' at the far right end.

Note: all Skull Butter Lippert.

This is a blank, aged, cream-colored page, likely an endpaper or flyleaf from an old book. The paper has a slightly textured appearance with some minor discoloration and faint horizontal ruling lines. The top edge shows some faint, illegible markings, possibly from the reverse side or a previous page. The page is otherwise empty of text or illustrations.

This image shows a blank, aged, cream-colored page, likely an endpaper or flyleaf of a book. The paper has a slightly textured appearance with some minor creases and discoloration, characteristic of old paper. The left edge of the page is bound into the book's spine, showing the inner structure of the binding. The overall tone is a warm, off-white or light beige.

SLD994-0132

Lloyd's Register
Foundation

Sunderland

SBC Co

5/507124



Midship Section

Sp. Hamgalt



SUNDERLAND.

Ref. 14 1/2 1/2

17675

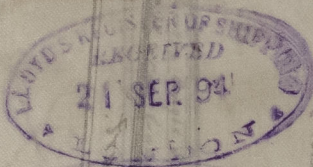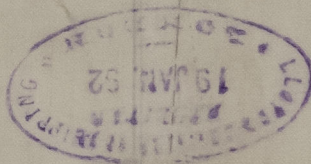

Merionethshire

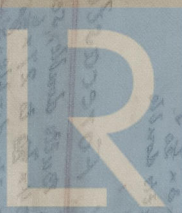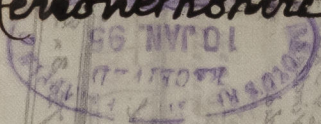

© 2021 Lloyd's Register Foundation

NWC994-0132