


PROFILE

S.S. N° 321.

"Whitgift"

Scale 1/8" = 1 foot

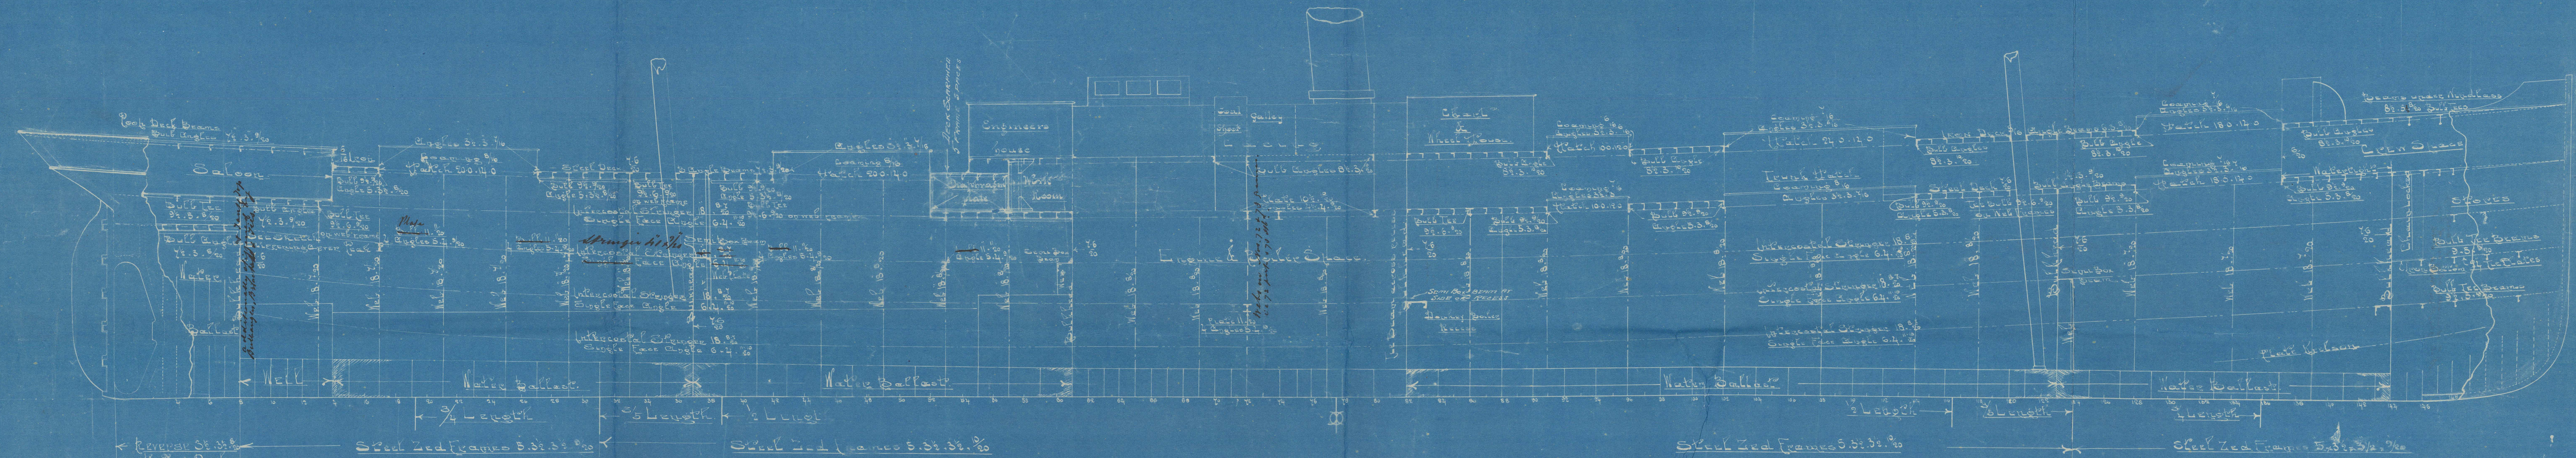

Joseph L. Thompson & Sons
Iron & Steel Shipbuilders
North Shields
Sunderland

J. L. Thompson
Sons (Ld.)



Vo. 321.

Profile.

H. S. Whitgift.

SUNDERLAND. No. 12. 2/26



© 2021

Lloyd's Register
Foundation
SLD995-0004