


See letter


26.6.94

SKETCH SHOWING PROPOSED METHOD OF
FLANGING HOLD STRINGERS IN LIEU OF TEE FACE BAR
S. S. NO 188.

SECTIONAL ELEVATION

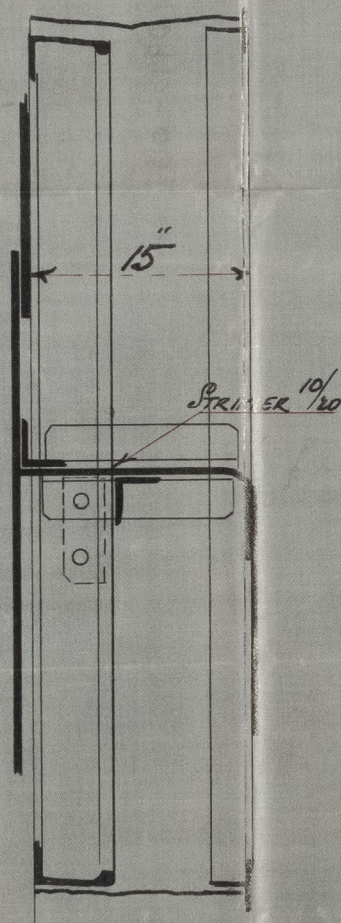


FRONT ELEVATION.

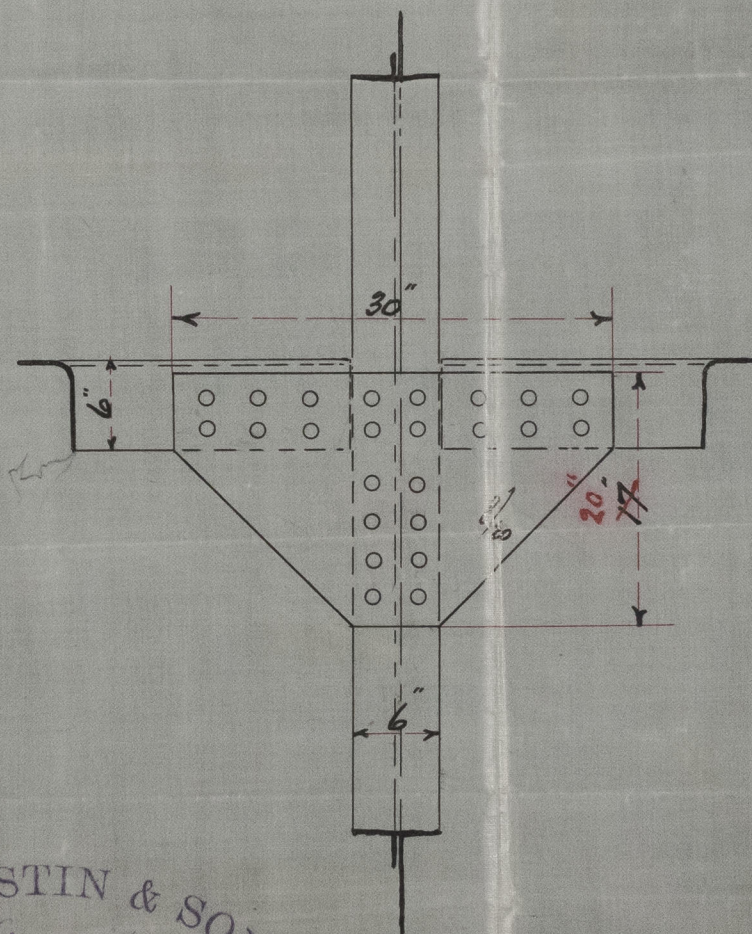

S. P. AUSTIN & SON
IRON & STEEL SHIPBUILDERS
AND
REPAIRERS
SUNDERLAND

Same as in No 183. & 185.
19-6-94.

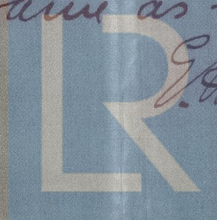

Lloyd's Register
Foundation

SLD995-0122



Be
C
A
P
E
N

AUSTIN & SON'S
- N^o 188 -
FLANGING OF
STRINGERS
"HARLINGTON"


SUNDERLAND
14802






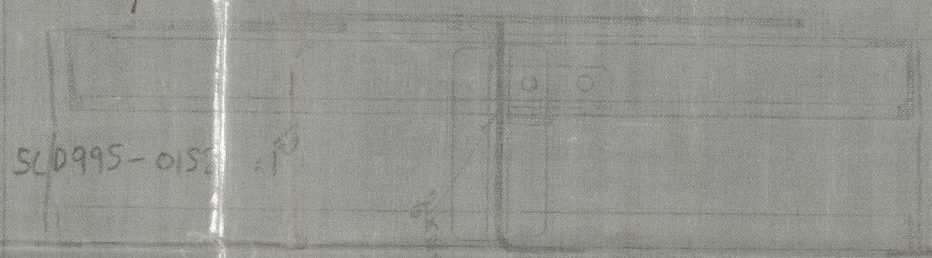

50995-0155

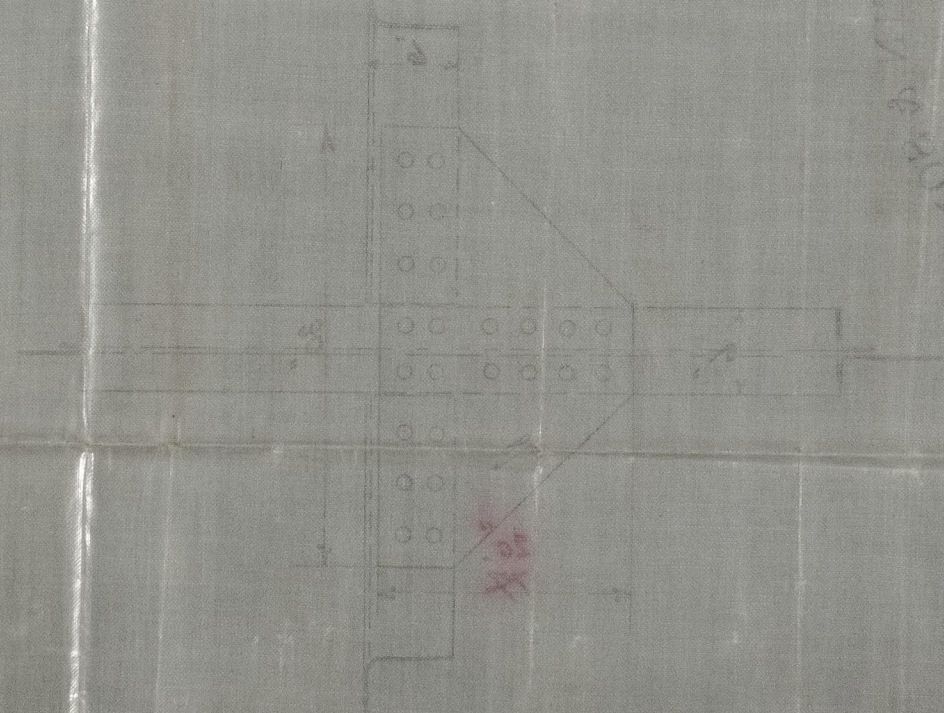


10
11
© 2021
Lloyd's Register
Foundation