

Ref. 9:94
 4/19/94




SCOTIA ENGINE WORKS BOILER

SCALE: 1" INCH TO ONE FOOT

WORKING PRESSURE 160 PSI

1/2" PLATE 85-27
 1/2" RIVET 86-0

ALL PLATES & STAYS OF STEEL
 "TUBES OF WROUGHT IRON"
 "RIVET HOLES DRILLED IN PLACE"

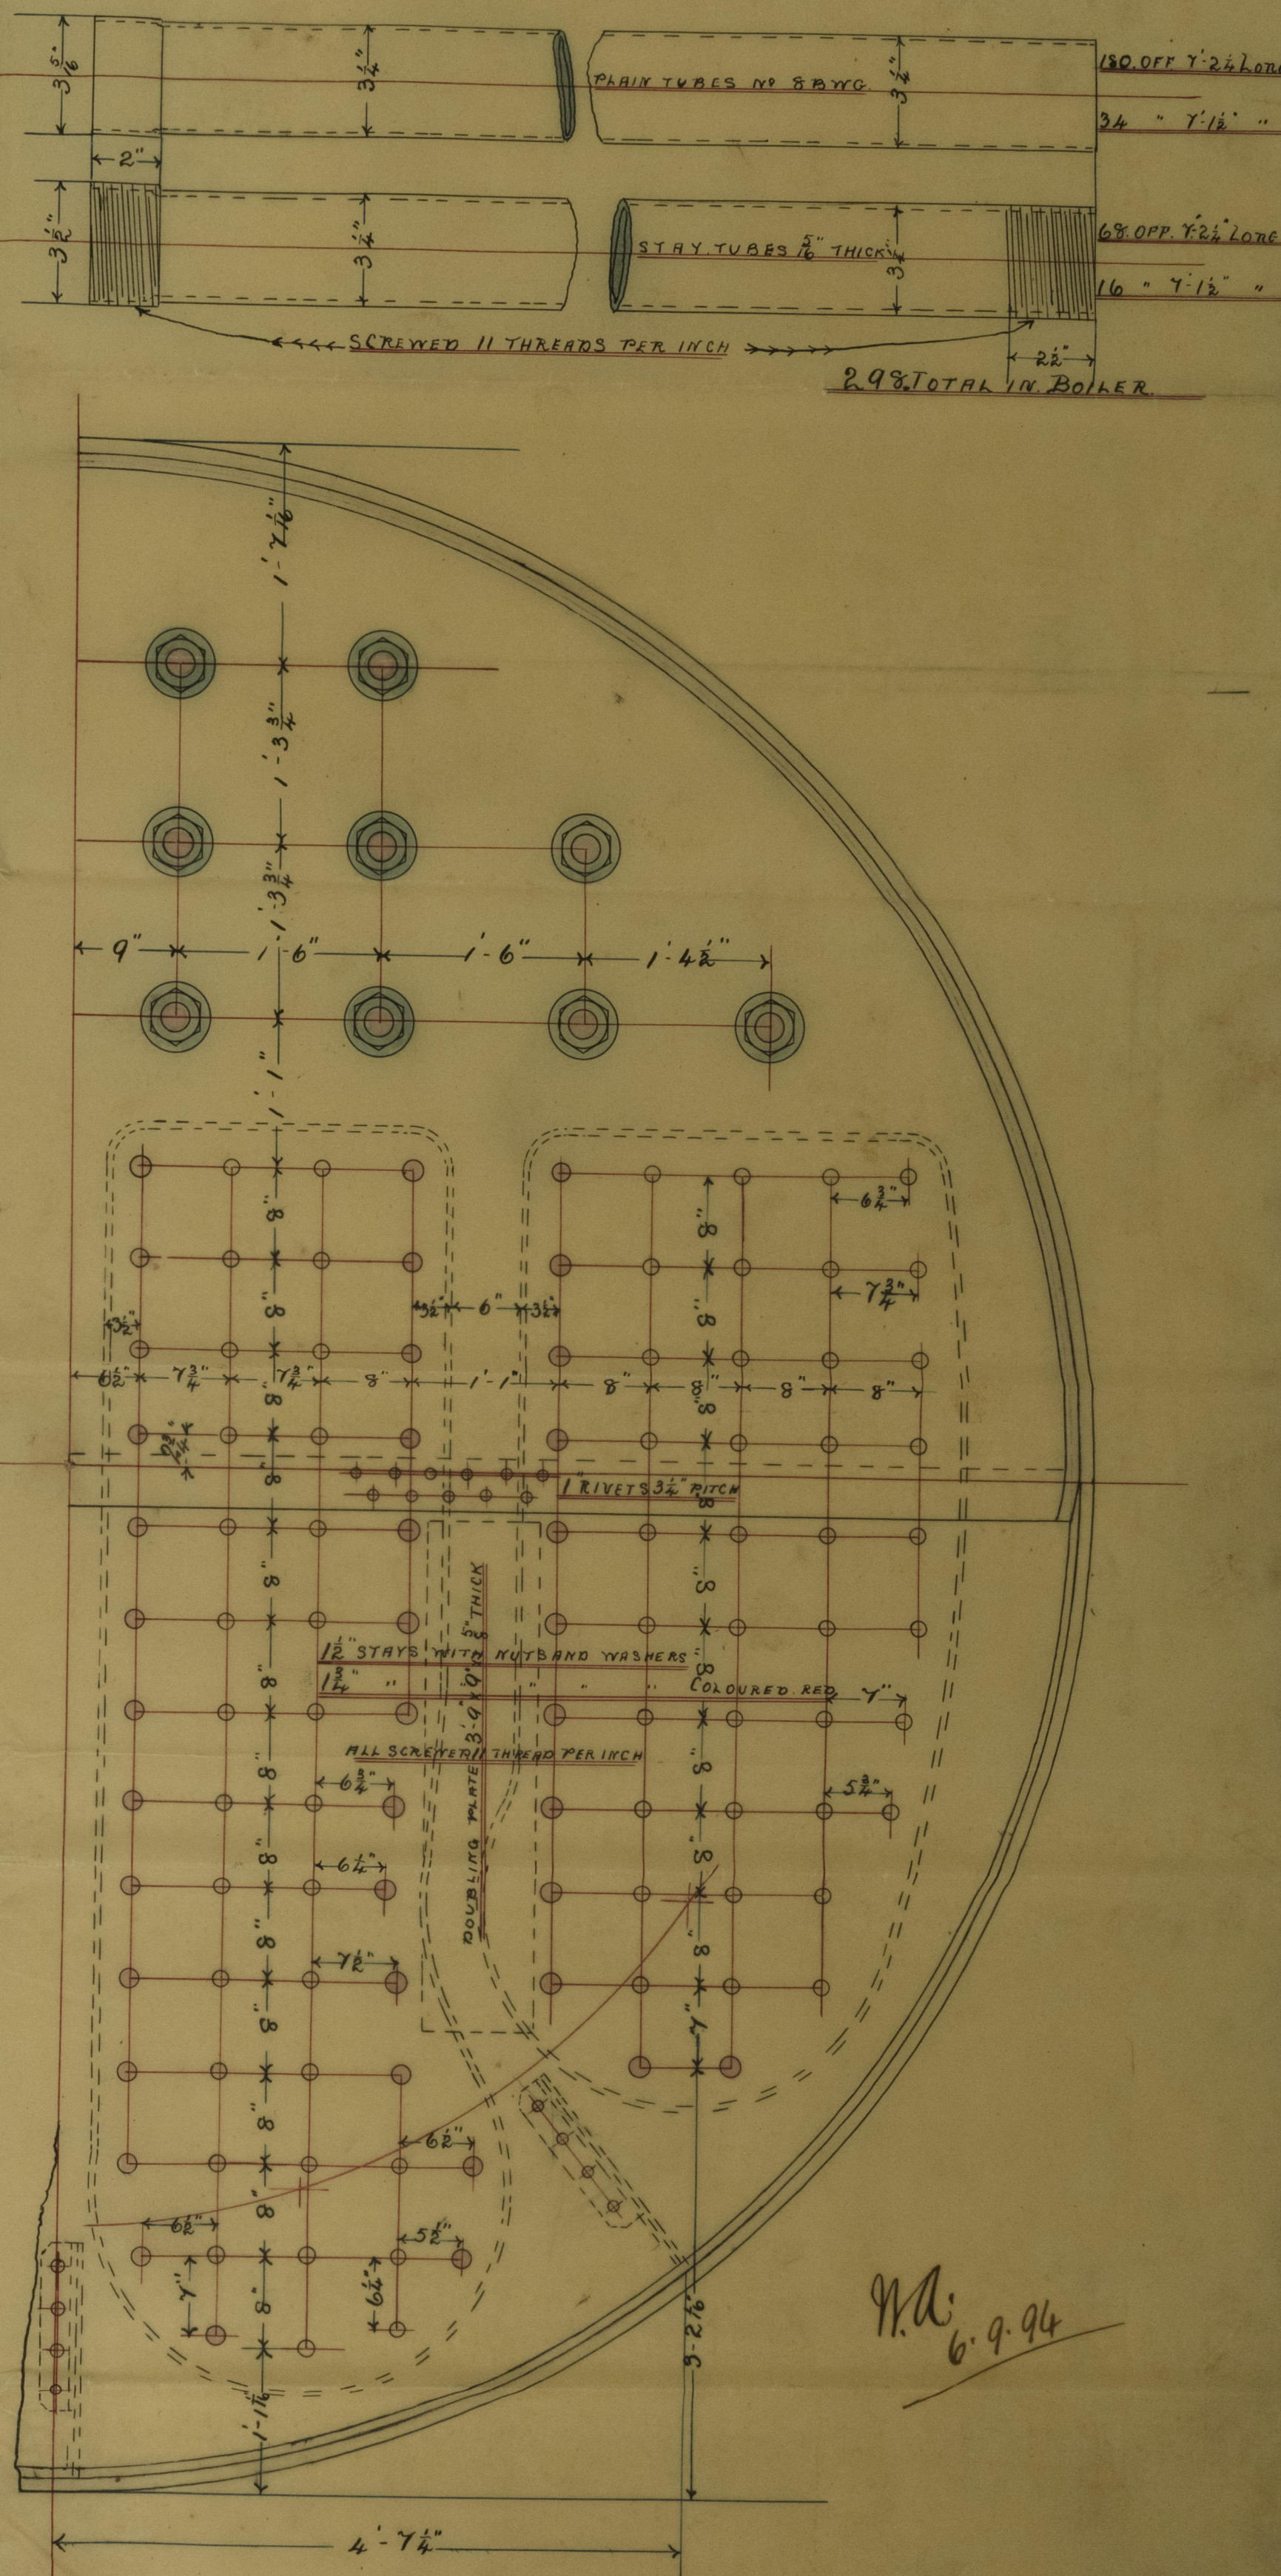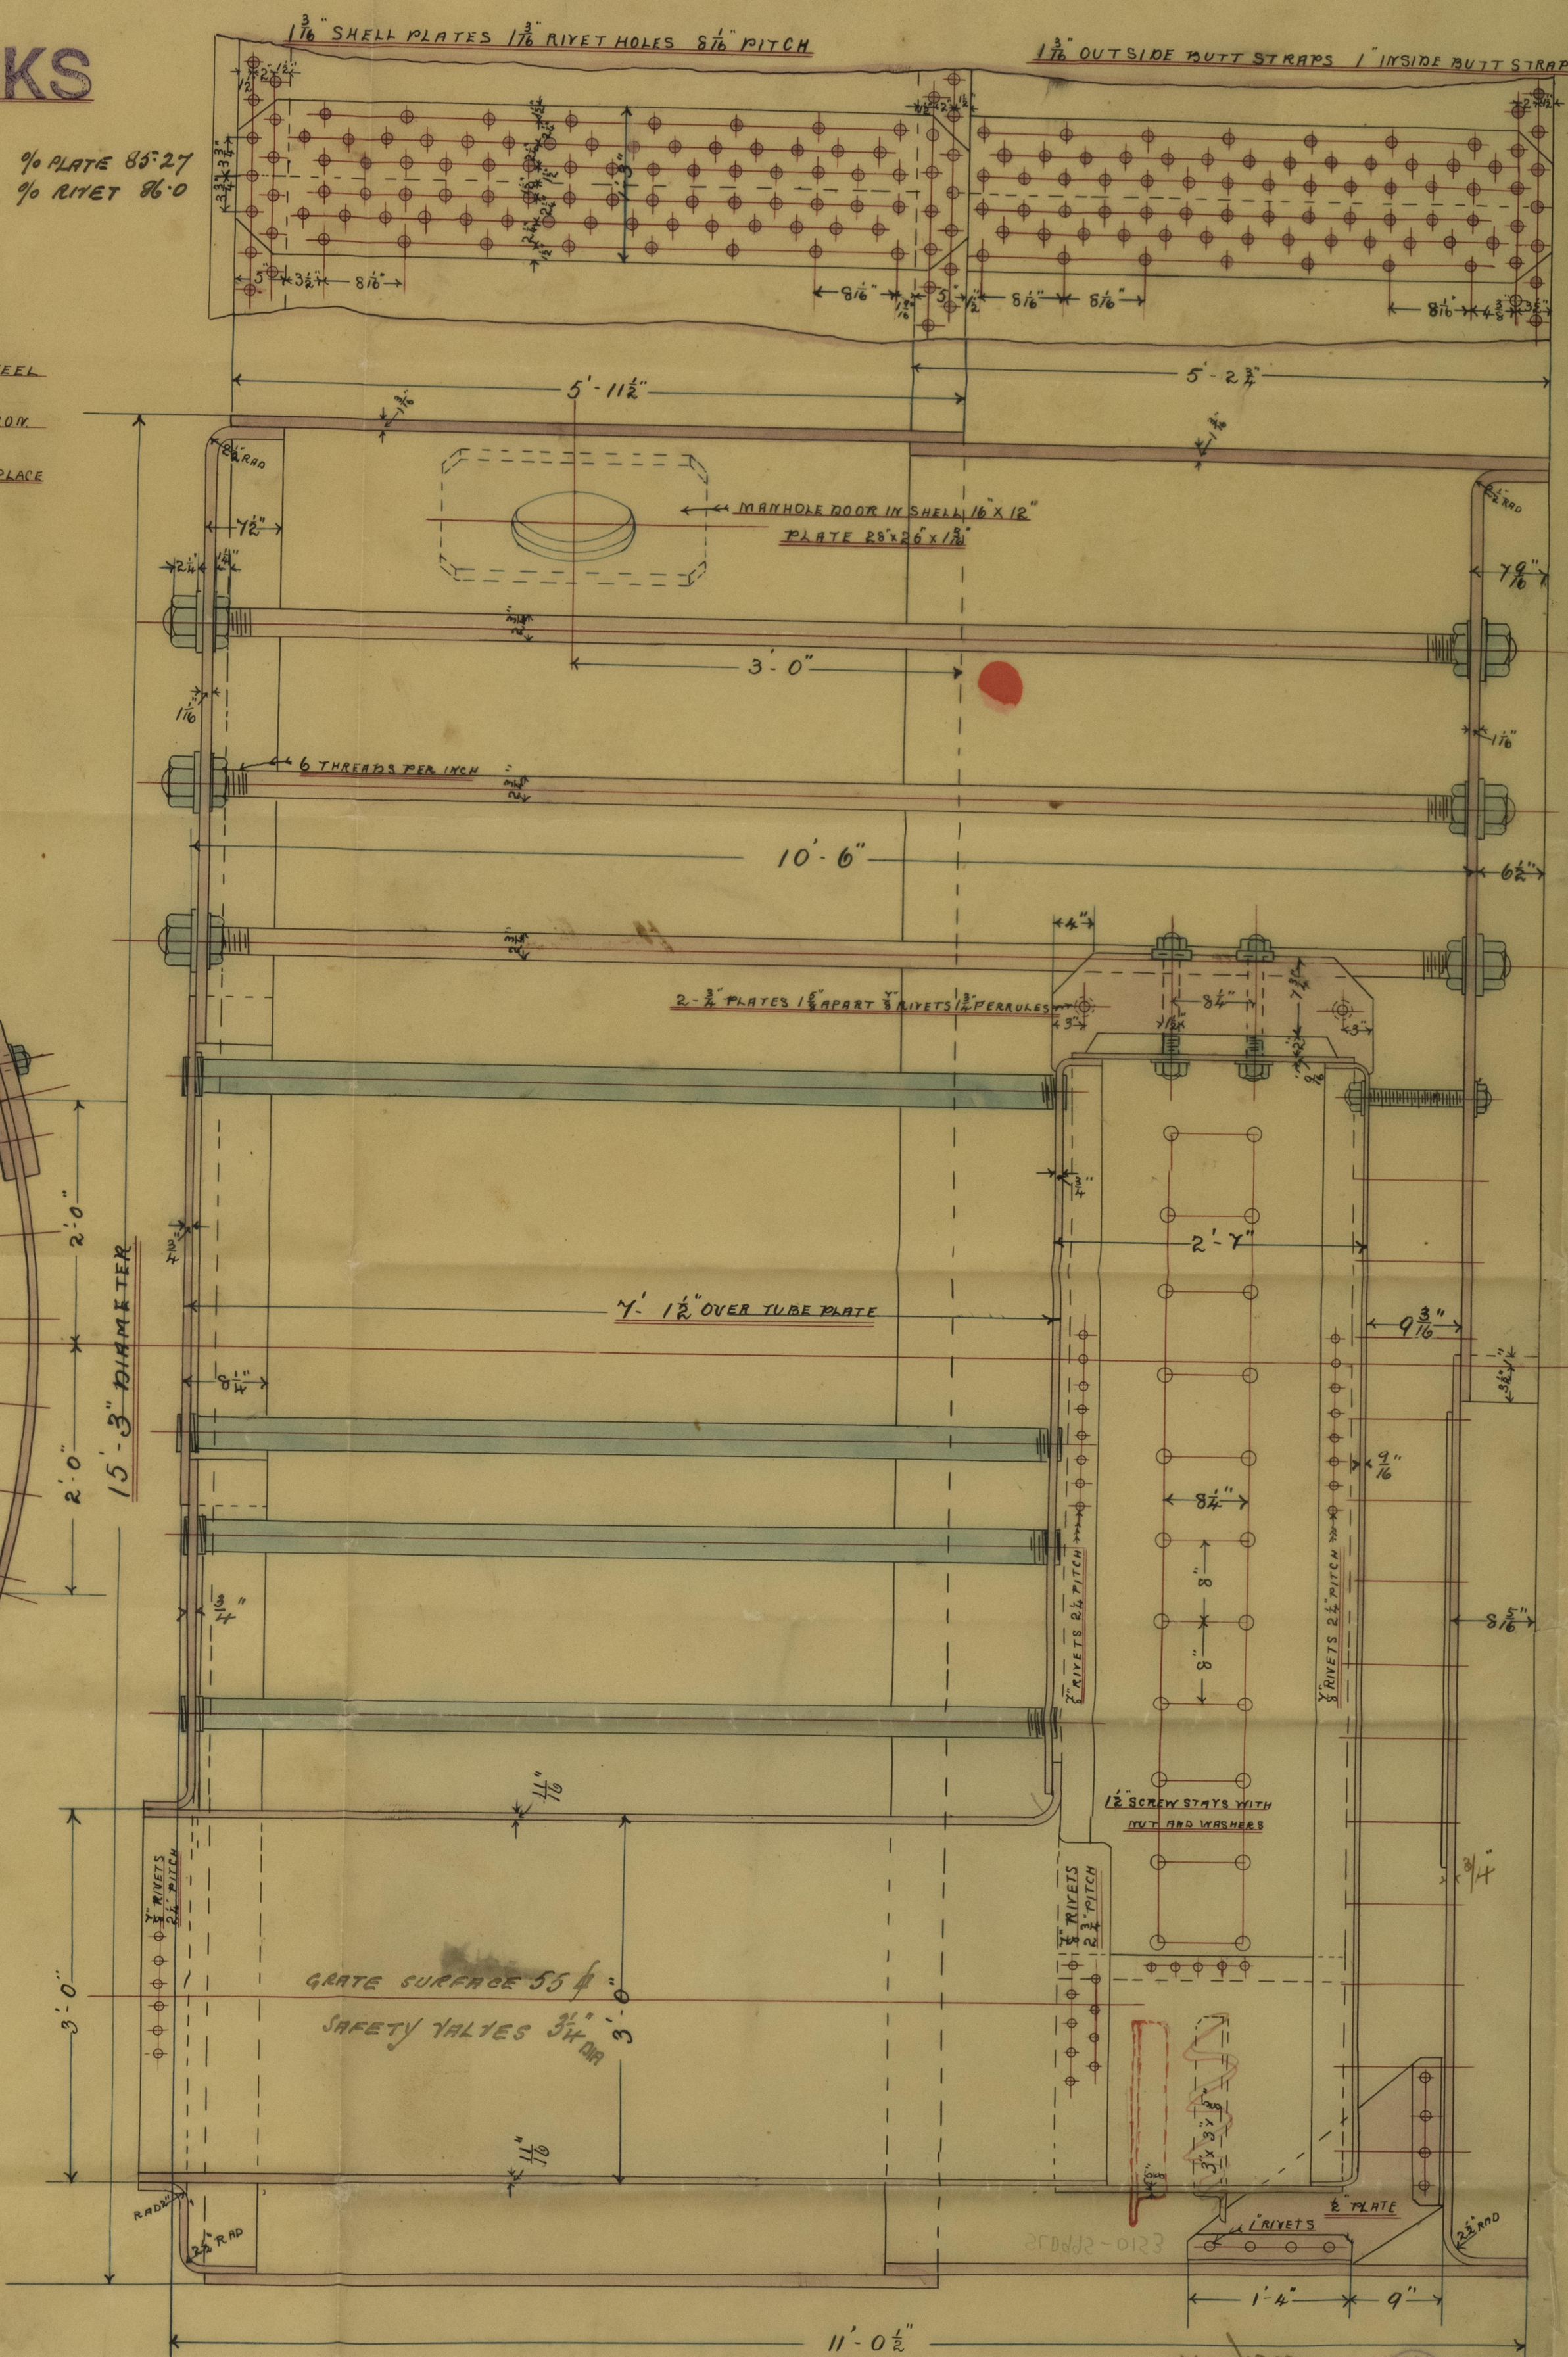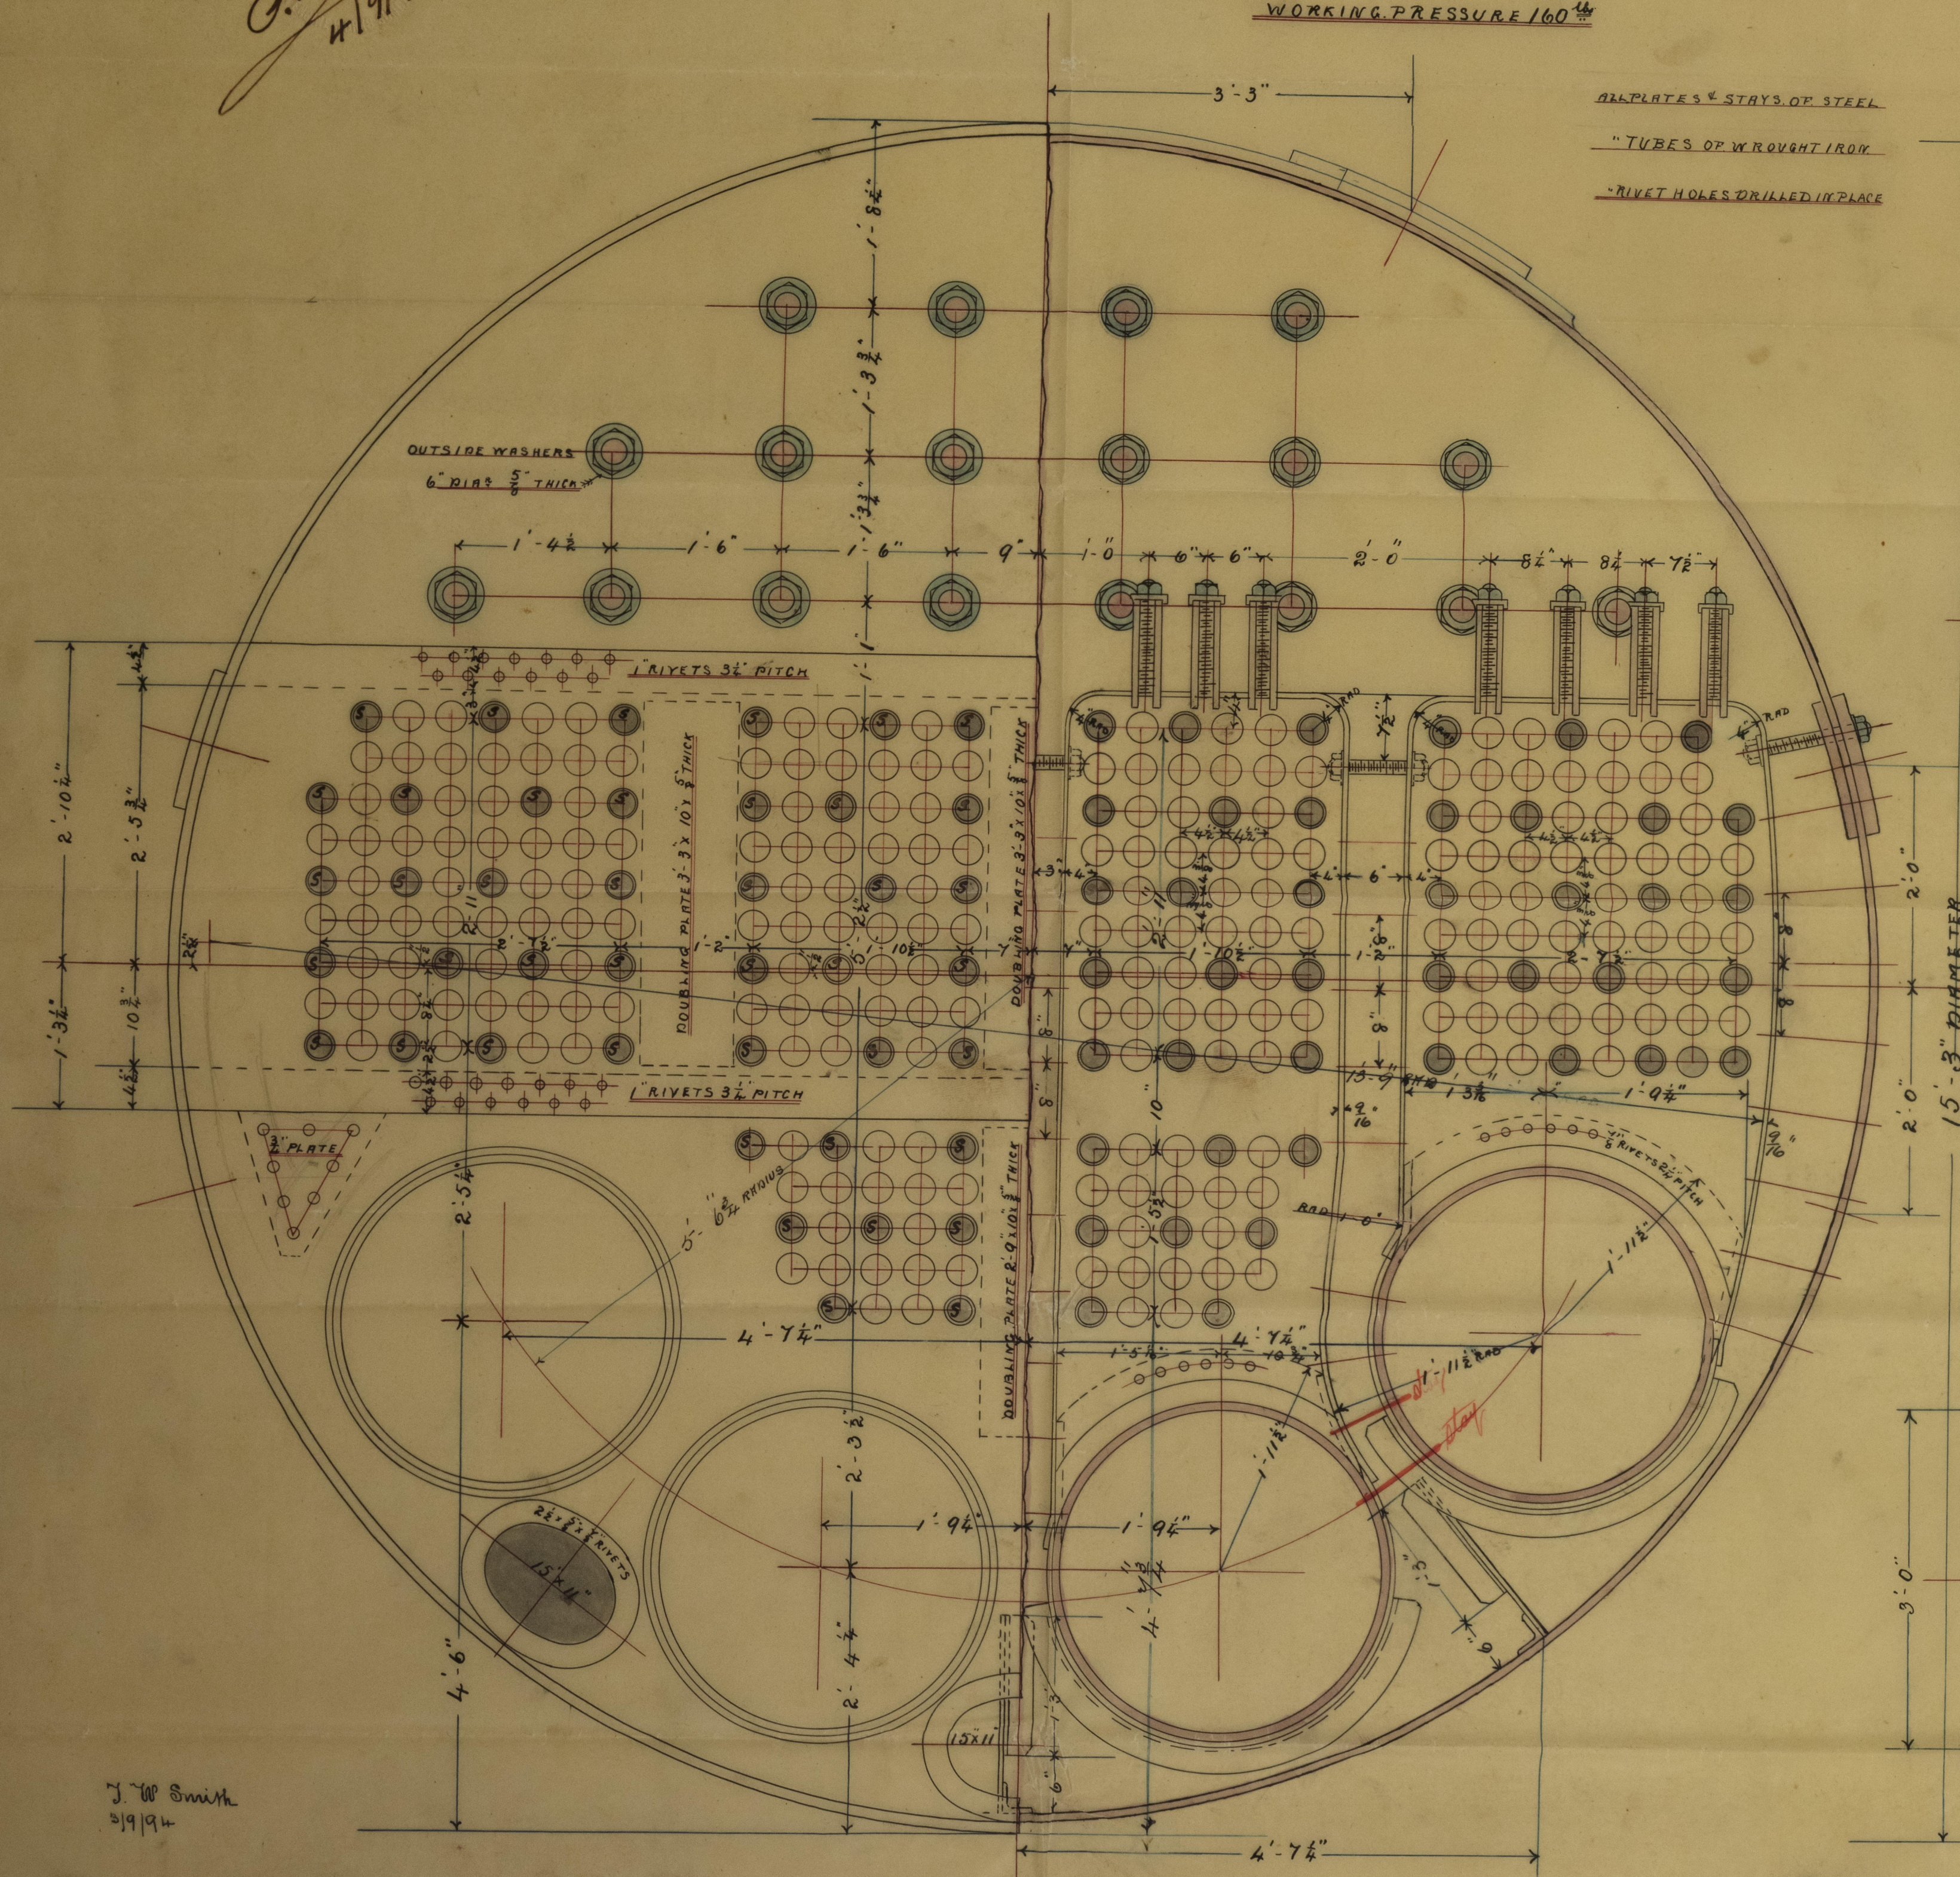

CONTRACT No 157 / THUS.

J. W. Smith


W.A. 6.9.94


S. P. Austin's No 288
W. Allen No 288-154

S. S. "Harlington"

11-05

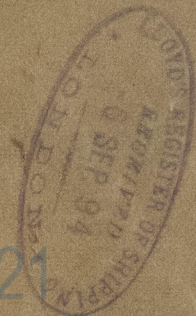

No 14.802

Lloyd's Register
Foundation