


S. P. AUSTIN & SON  
5 June 1914  
IRON & STEEL SHIPBUILDERS  
AND  
REPAIRERS  
Sunderland



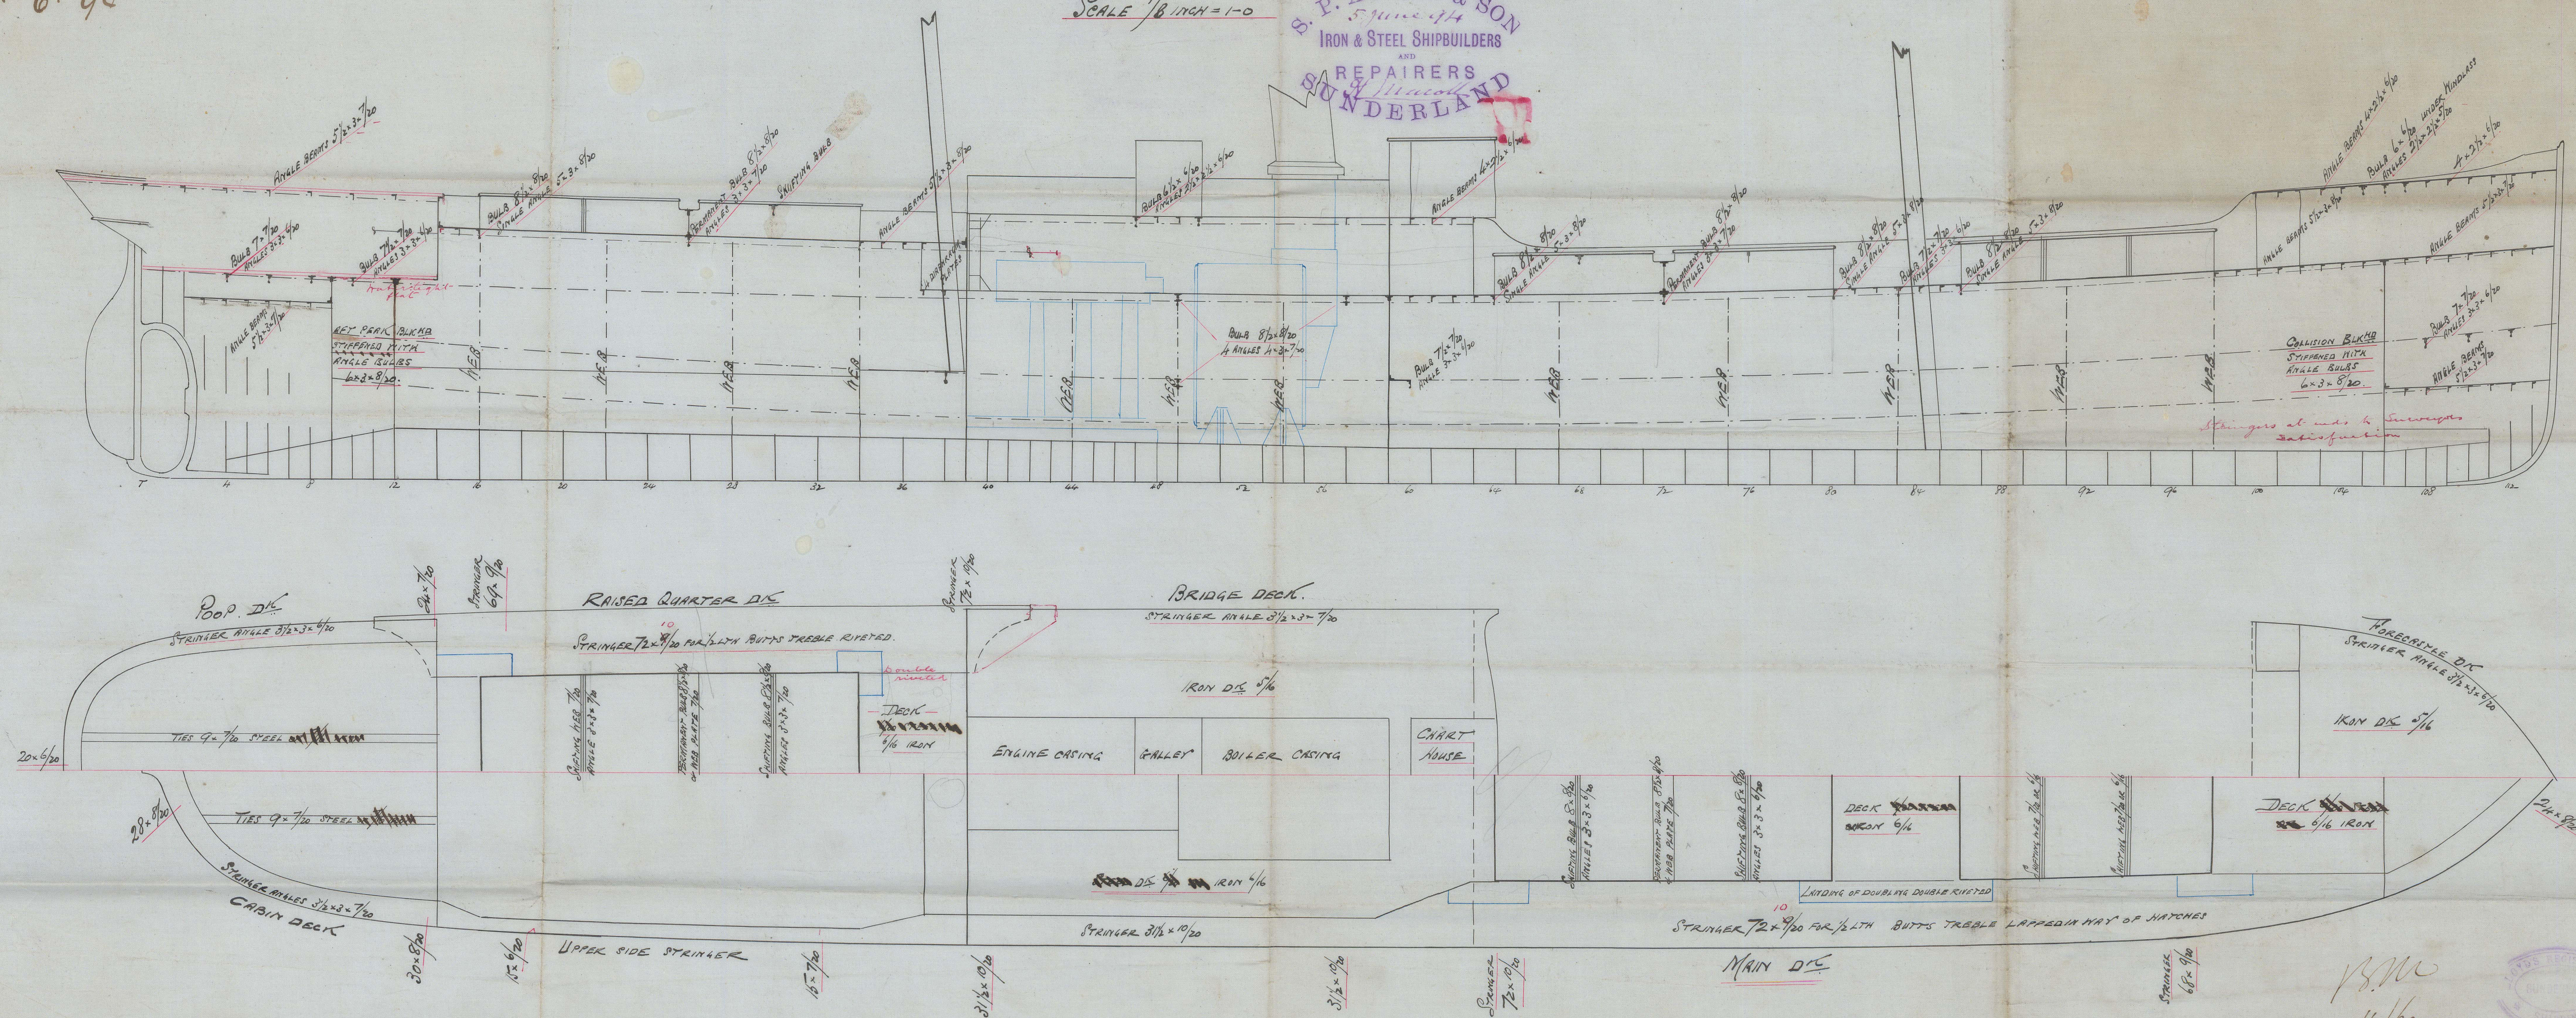

S. P. AUSTIN & Son  
S. S. N<sup>o</sup> 168  
PROFILE



"  
S. S. HARLINGTON  
"

---

14802

© 2021

Lloyd's Register  
Foundation

SLD 995-0154