





**S.S. N<sup>o</sup> 188**  
**TANK & HOLD PUMPING PLAN**

UNDER DECK TONNAGE ABT 752 TONS

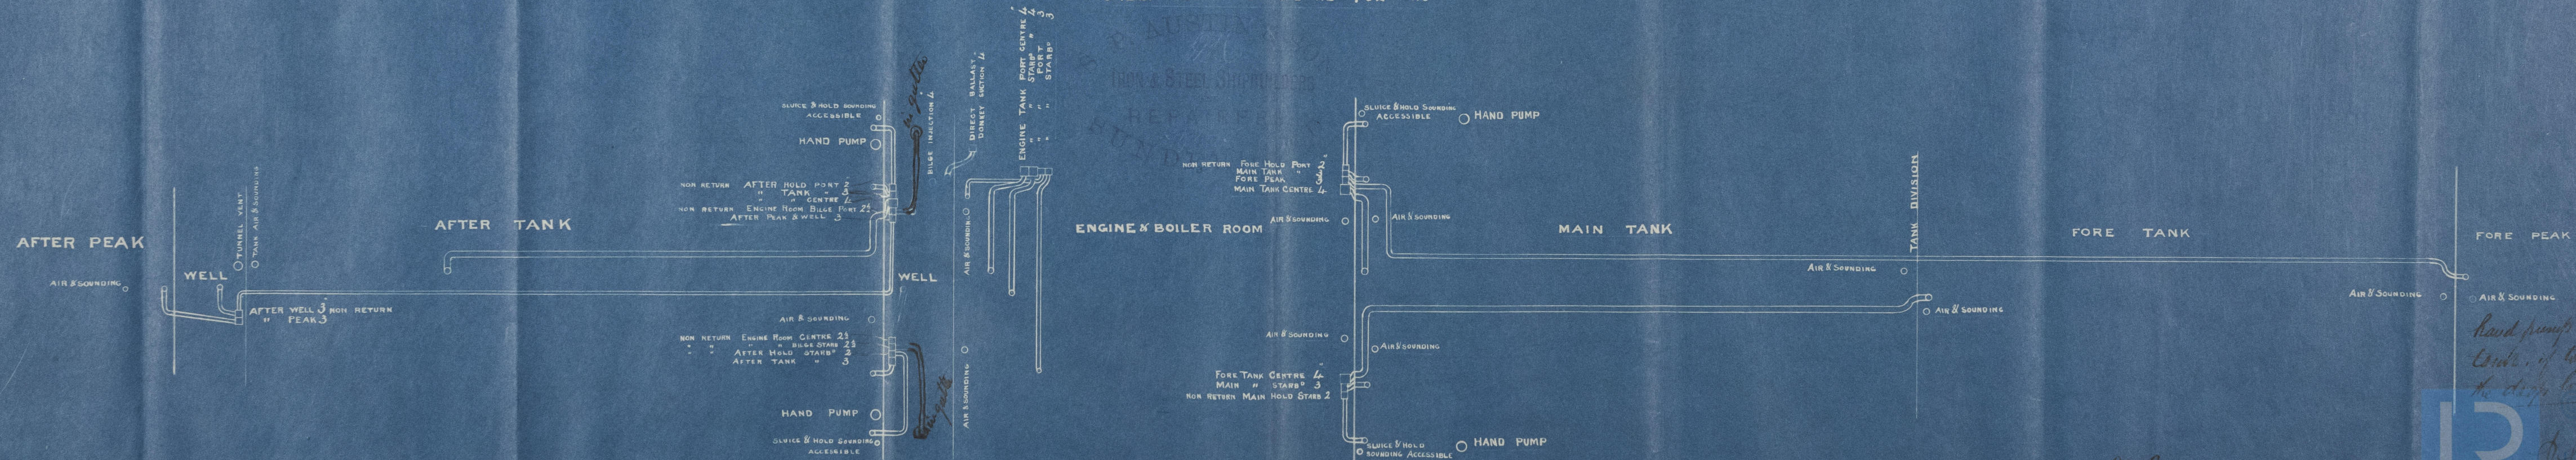

*Hand pumps on top of fore peak  
Cords, if top of tanks be under  
the deep lead line.*

*N.A.  
6.2.95*

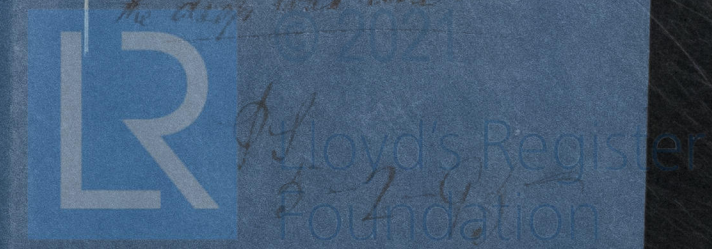

SLD975 0155




S. P. Austin & Son  
S.S. No 188

---

Pumping Arrangement  
S.S. "HARLINGTON"

---

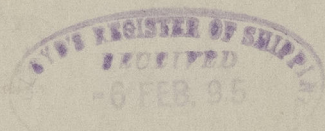

SUNDERLAND. 14802



© 2021

Lloyd's Register  
Foundation

SLD995-0155