

Lloyd's Register of British and Foreign Shipping.

(Report on Vessel No. 14802 Port SUNDERLAND.)

Sunder

No. 2847a.

SHIP FORGINGS OR CASTINGS.

I have to report that the undermentioned Iron ~~or Steel~~ Forgings ~~or Castings~~,
manufactured by Messrs R S Bagnall Sons
of Wylton for the Vessel No. 188, being built
by Messrs S P Austin Sons of Sunderland
have been inspected by me as set forth below, and found to be, so far as can be seen,
sound.

Mark on Forgings.

Lloyd's

No. 2847a

R.C.

Wugh Cameron

Sunderland


21. 2. 95

	STERN FRAME.	RUDDER FRAME.	STEM.
Material*	<u>Scrap iron</u>	<u>Scrap iron</u>	<u>Scrap iron</u>
How made	<u>Forged</u>	<u>Forged</u>	<u>Forged</u>
Dimensions	<u>7 1/4 x 1 1/4 x 3/4</u>	<u>5 1/4 - 3 1/2</u>	<u>7 x 2 1/4</u>
Progress on Inspection	<u>Forged & smithed</u>	<u>Forged & smithed</u>	<u>Forged</u>
Date when Inspected	<u>July 7th to 30/94</u>	<u>Jan'y 24th to Feb'y 9/95</u>	<u>Sept 3/94</u>

SKETCHES OF FRAMES SHOWING POSITION AND DESCRIPTION OF WELDS OF FORGINGS, OR PARTICULARS OF TESTS APPLIED TO CASTINGS.



Welds

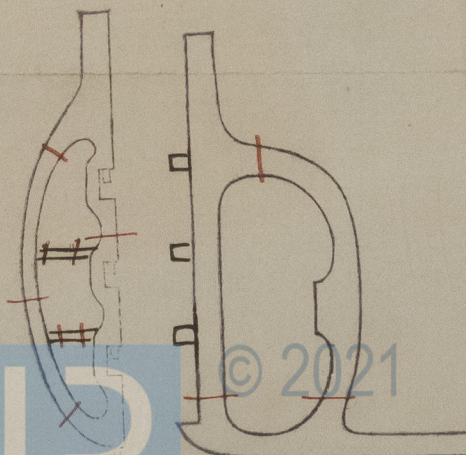

Fee (if any chargeable) £

To be paid at

* If of Iron, state whether scrap or puddled Iron.