

Lloyd's Register of British and Foreign Shipping.

(Report on Vessel No. 18.207 Port SUNDERLAND.)*Sund*
No. 3140-a.

SHIP FORGINGS OR CASTINGS.

I have to report that the undermentioned Iron ~~or Steel~~ Forgings ~~or Castings~~,
 manufactured by The Wraith Quay Forge Co.
 of Sunderland for the Vessel No. 546, being built
 by Mr James Laing of Sunderland
 have been inspected by me as set forth below, and found to be, so far as can be seen,
sound.



Mark on Forgings.

Lloyd's

No. 3140a
No. 6.*Ralph Cameron**Sunderland**30-11-95.*

	STERN FRAME.	RUDDER FRAME.	STEM.
Material*	<i>Scrap iron</i>		<i>Scrap iron</i>
How made	<i>Forged</i>		<i>Forged</i>
Dimensions	<i>10' x 5 1/2'</i>		<i>10' x 2 1/2'</i>
Progress on Inspection	<i>Forged & Smithed</i>		<i>Forged</i>
Date when Inspected	<i>Oct 5th to Nov 26/95</i>		<i>Sept 14 Oct 5/95</i>

SKETCHES OF FRAMES SHOWING POSITION AND DESCRIPTION OF WELDS OF FORGINGS, OR PARTICULARS OF TESTS APPLIED TO CASTINGS.

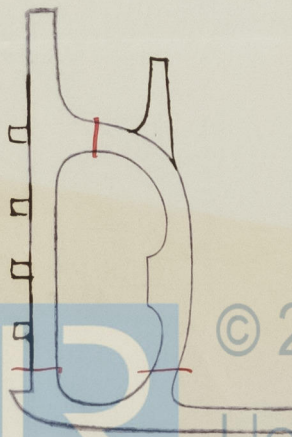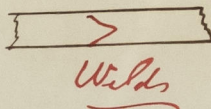

Fee (if any chargeable) £ : :

To be paid at

* If of Iron, state whether scrap or puddled Iron.