


Numerals		
7.9.95	1/2 Girth	33.33
1.10.95	1/2 Breadth	20.50
4.11.95	Depth	17.96
		$71.79 \times 318.33 =$
		<u>22852</u>

Proportions.
 7.76 Breadths in Length
 17.72 Depths to Main Deck.
 12.71 Depths to Spar Deck.

Midship Section
 Screw Steamer No. 546. #547 app. #14 95
 Length 320.0 Breadth 41.0 Depth Mold 24.2.
 Class 100A1 at Lloyds
 Spardecked.
 Scale 1/2 Inch = 1 Foot.

Equipment No.		
1/2 Girth	40.41	
1/2 Breadth	20.50	
Depth	25.04	
		$85.95 \times 318.33 =$
		<u>27360</u>
Erections		1568 1815
		<u>28928</u>
		29175
Deck	10.0	
Bridge	114.0	118.0
Forecastle	32.0	40.0
		<u>146.0</u>
		169.0

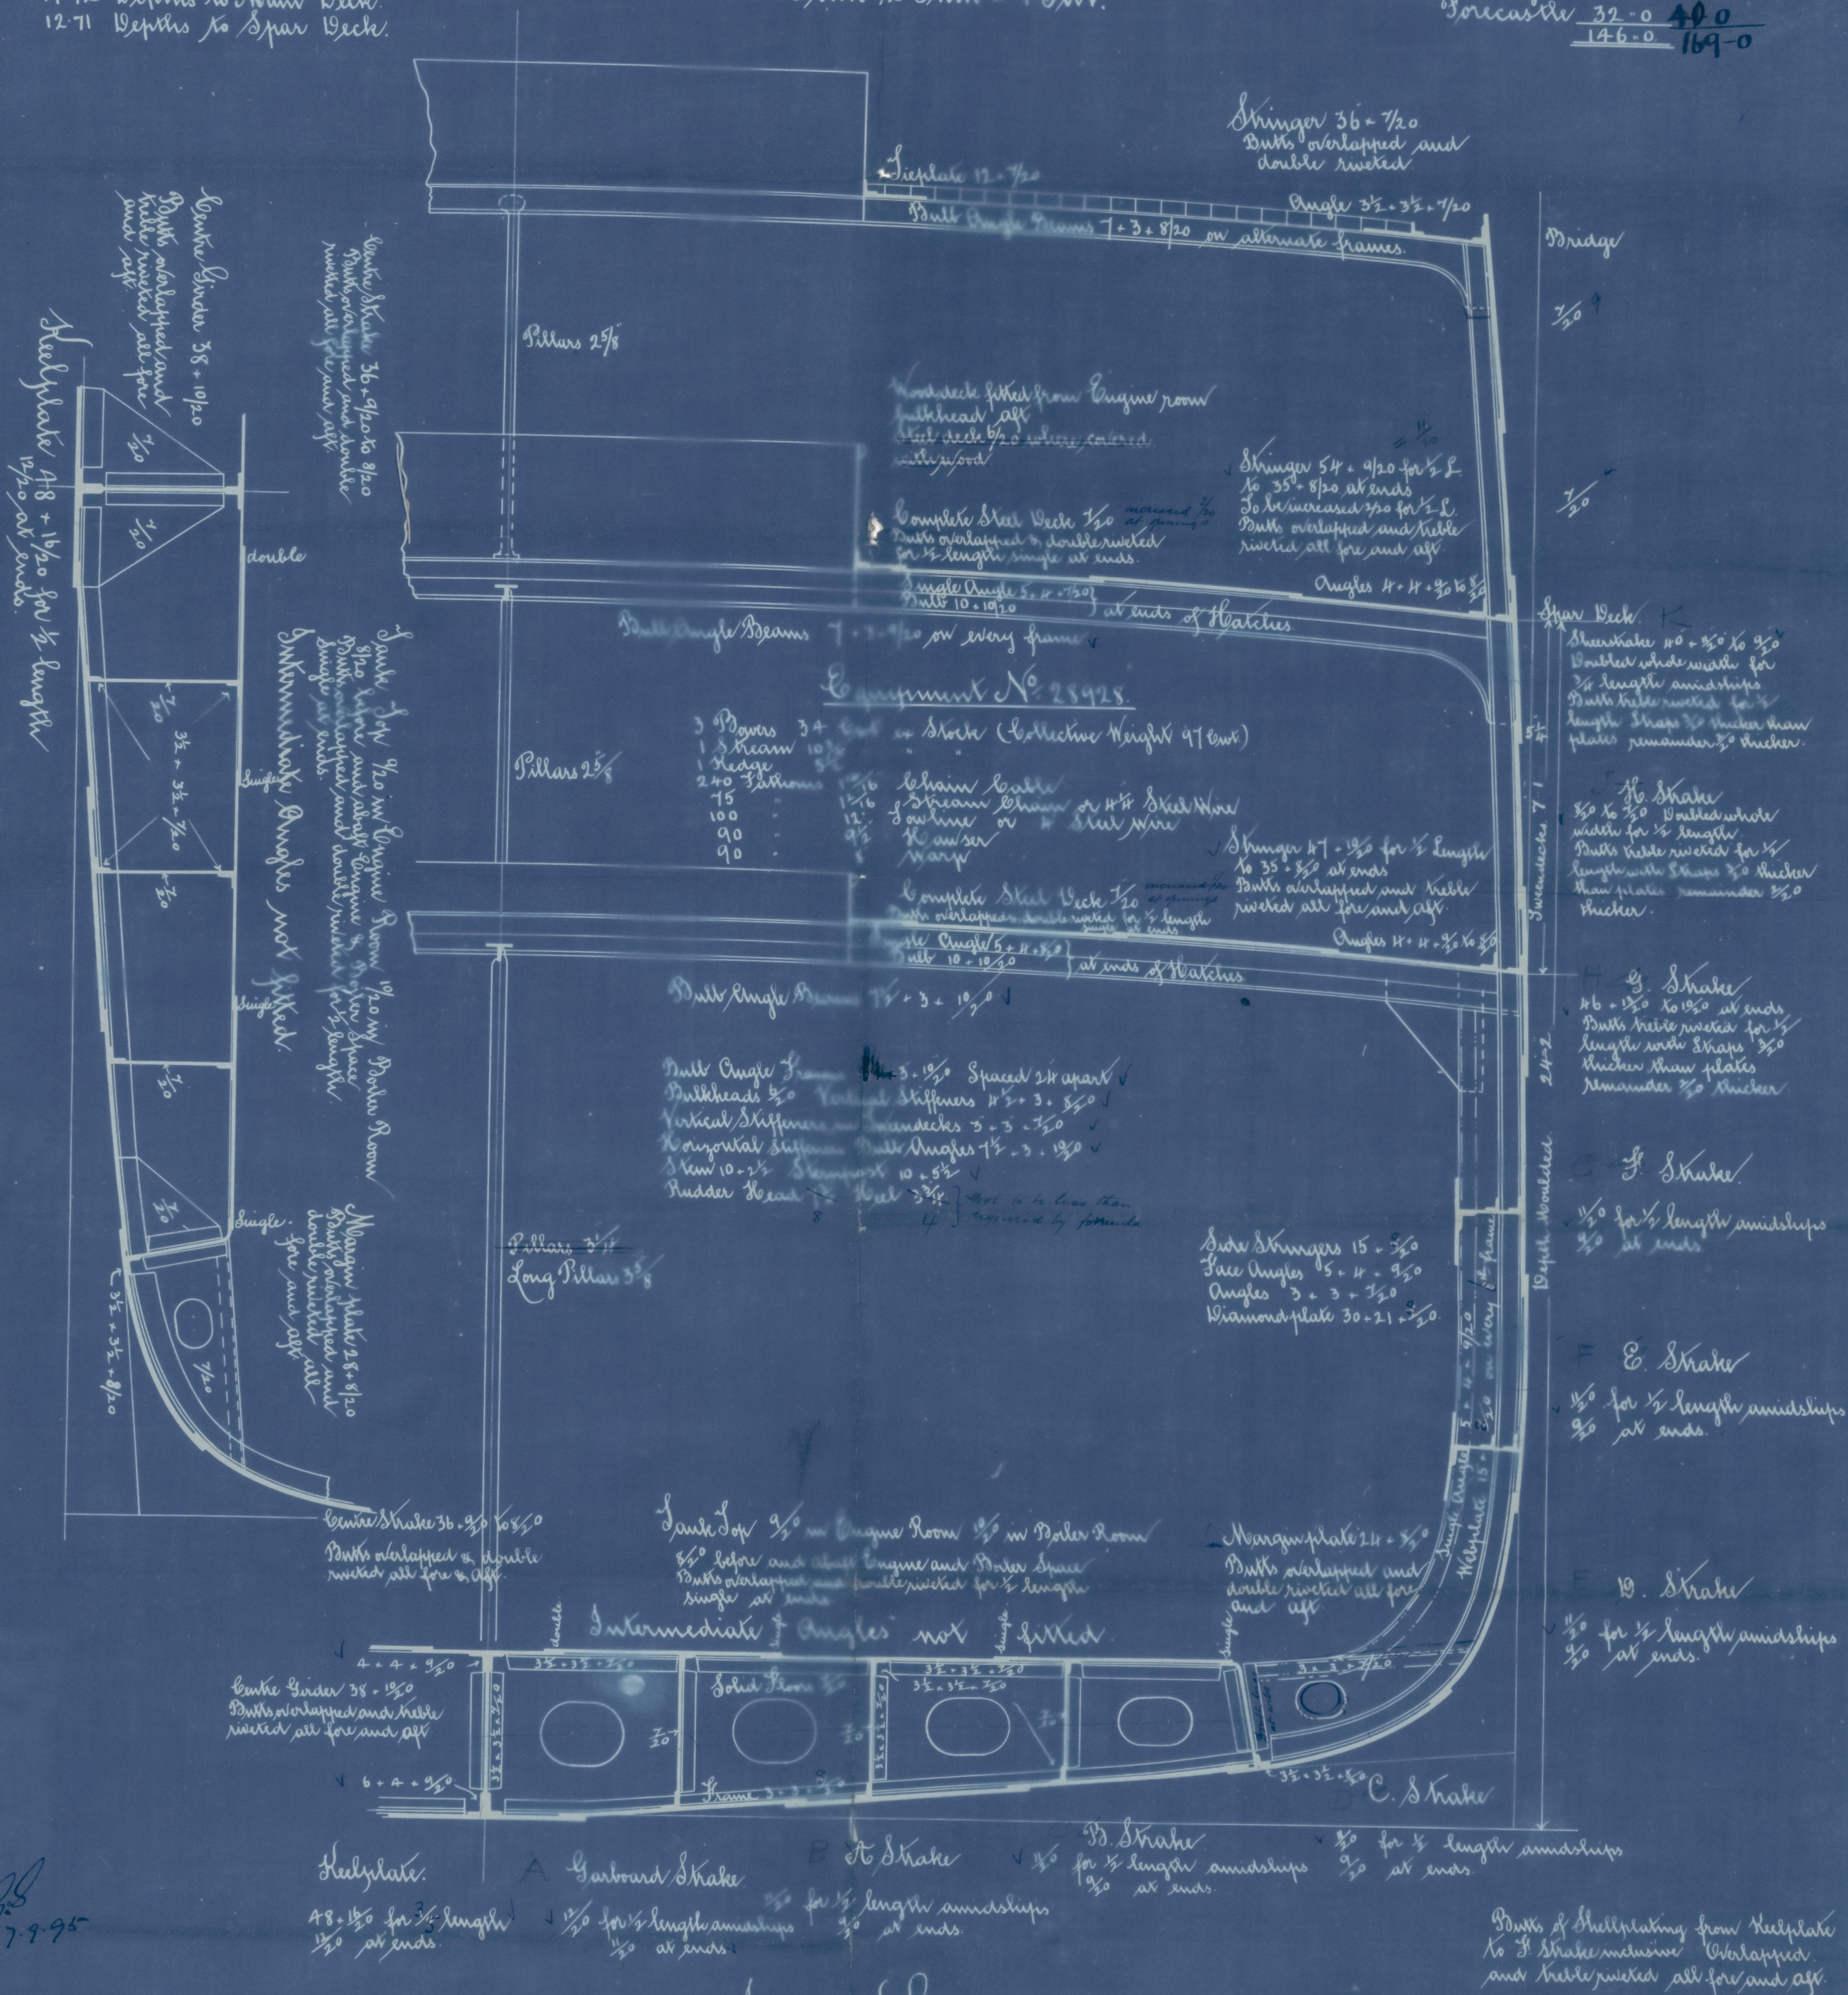

James Laing
 Deptford Yards
 Sunderland.

James Laing
No 546 + 547


Mia Section
S.S. "UMTALI"

Sunderland.
18 201

No 547
S.S. UMVOTI

Sld 18400

SLD999-0182

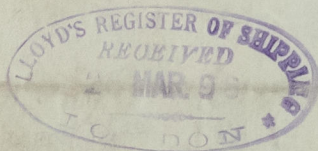

© 2021

Lloyd's Register
Foundation