


# S.S. N<sup>o</sup> 546 & 7

UMTALI

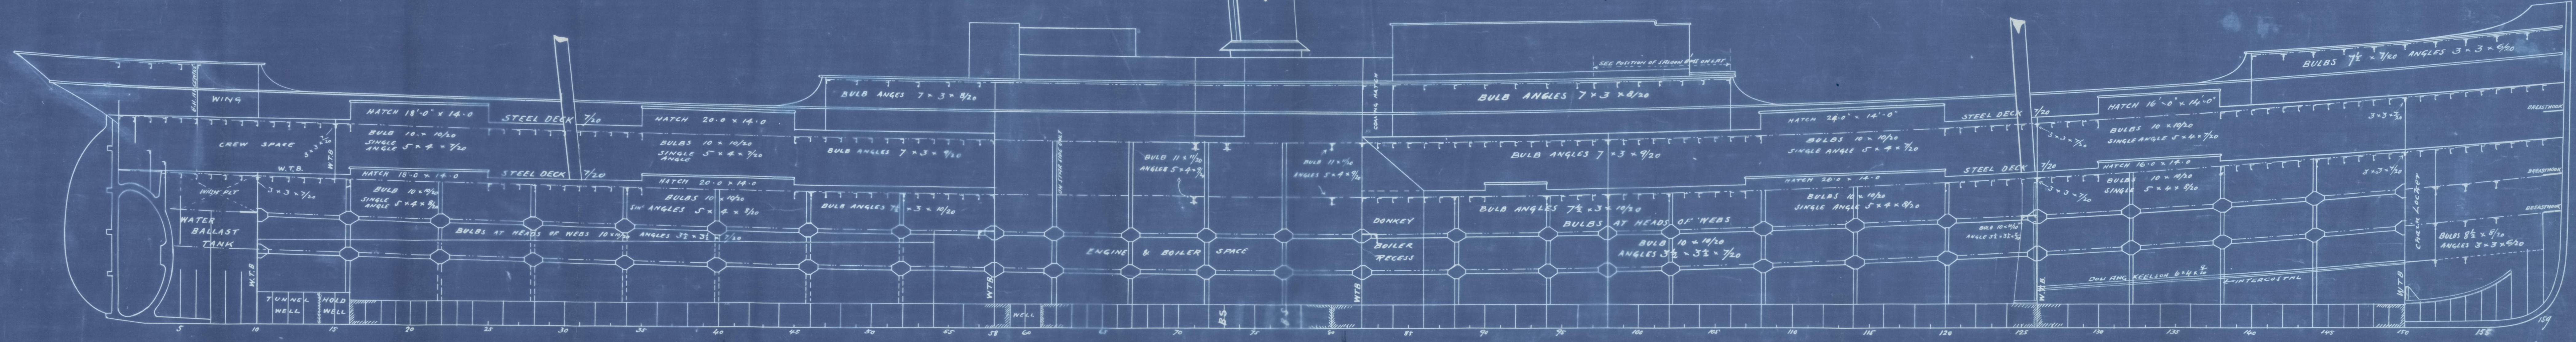

18/5  
26


"Mintali"  
Sld. 18201.

---

Corrected Profile  
(enclosed with  
Surveyor's letter  
of 18 May 1896)

---

500999-0184

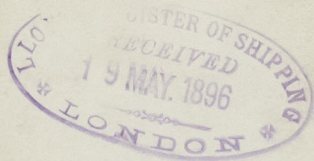

Mintali



© 2021

Lloyd's Register  
Foundation