


7-9-95  
4-11-95

Screw Steamer No. 546 & 547, app'd.  
4/11/95

3 Sept 1895  
Frame No. 22852  
11-79

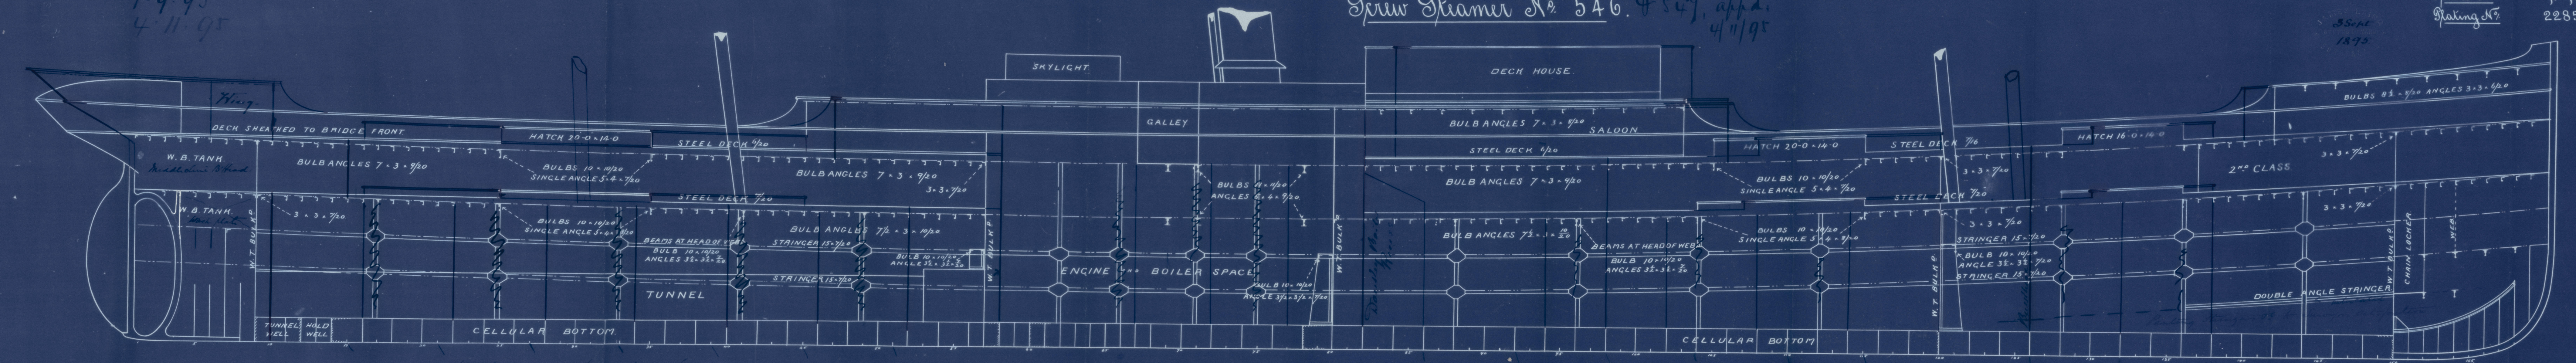

98  
7-9-95

Web frames in holds to be 6 frame spaces apart


Scale 1/8" = one foot.

Alterations in Red

Web frames in holds to be 6 frame spaces apart

JAMES LAING  
DEPTFORD YARDS  
SUNDERLAND.



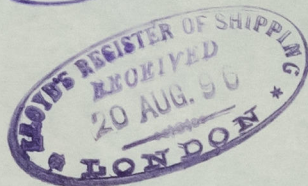

James Caird  
N<sup>o</sup> 546 + 547  
Profile  
S.S. UMTALI

SUNDERLAND. N<sup>o</sup> 18.201

N<sup>o</sup> 547  
S. S. U M V O T I

Slid 18400

SL0999-0186



© 2021

Lloyd's Register  
Foundation