
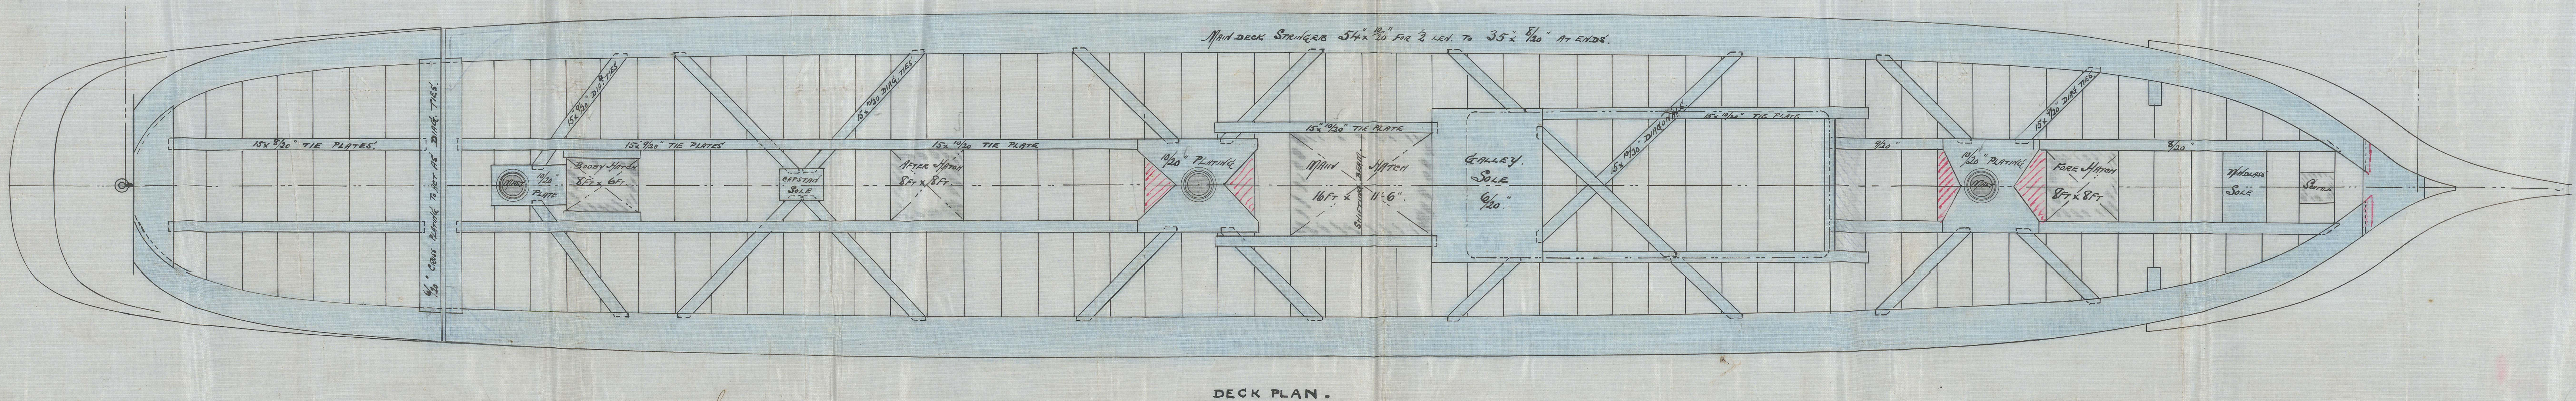


Construction - 1st
 or 2nd class
 "built in"

PROFILE AND DECK PLANS.
 FOR
SHIP, No 270.
SCALE 1/8" = ONE FOOT.
TO CLASS 100 A.I. AT LLOYDS.
STEEL.

"Annie Maud" Southampton Report No. 3247.

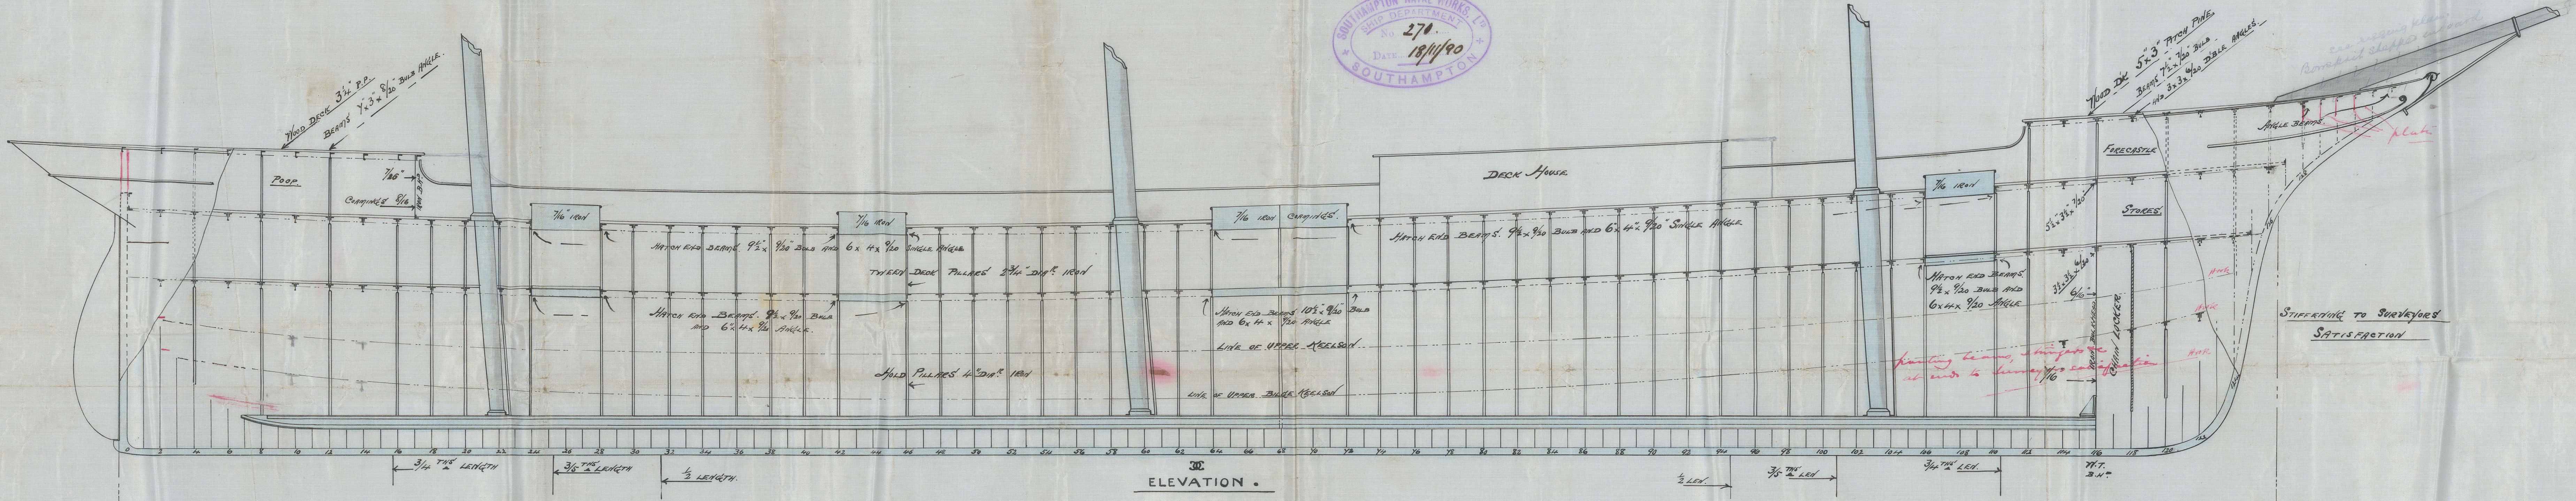

11.7.6
 27/1/90

220

500899-0070

Port - "Southampton"
SN Works Yard No 270

"Annie Maud"

Son 3247.


