

FRACTURE EXTENDS 2' FORD^o & AFT.
AND 2' ATHWARTSHIPS STAR^o SIDE.

FRACTURE EXTENDS 1' FOR^o & AFT.
AND 1' ATHWARTSHIPS STAR^o SIDE.

FRACTURE EXTENDS 2' FOR^o & AFT.
AND 1' ATHWARTSHIPS PORT SIDE.

FOR^o

THIS FRACTURE EXTENDS ALL^o ROUND
RUDDER POST.


THIS FRACTURE EXTENDS 4' FOR^o & AFT. AND
5' ATHWARTSHIPS PORT SIDE

AFT.

—SS. "BASIL"—

—SKETCH SHEWING FRACTURES IN RUDDER POST—

—SCALE 1" = 1 FOOT.—

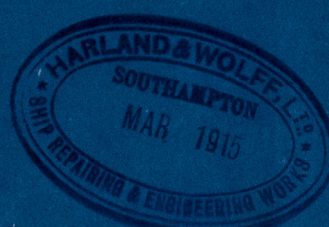

DRG No 280S


W.D.
6/3/15

2210-000005

S. S. "Basil"

Repair to Rudder Frame

Doc. Rpt. No. 9214

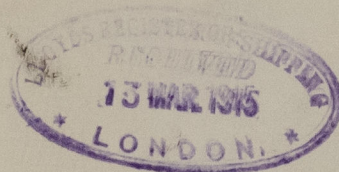

500900-0122



© 2021

Lloyd's Register
Foundation