


10.2.87

S. S. "Iron Acton" *Subst* Report No. 1630.  
 No 183 S.P. Foremast.

Pole Masts

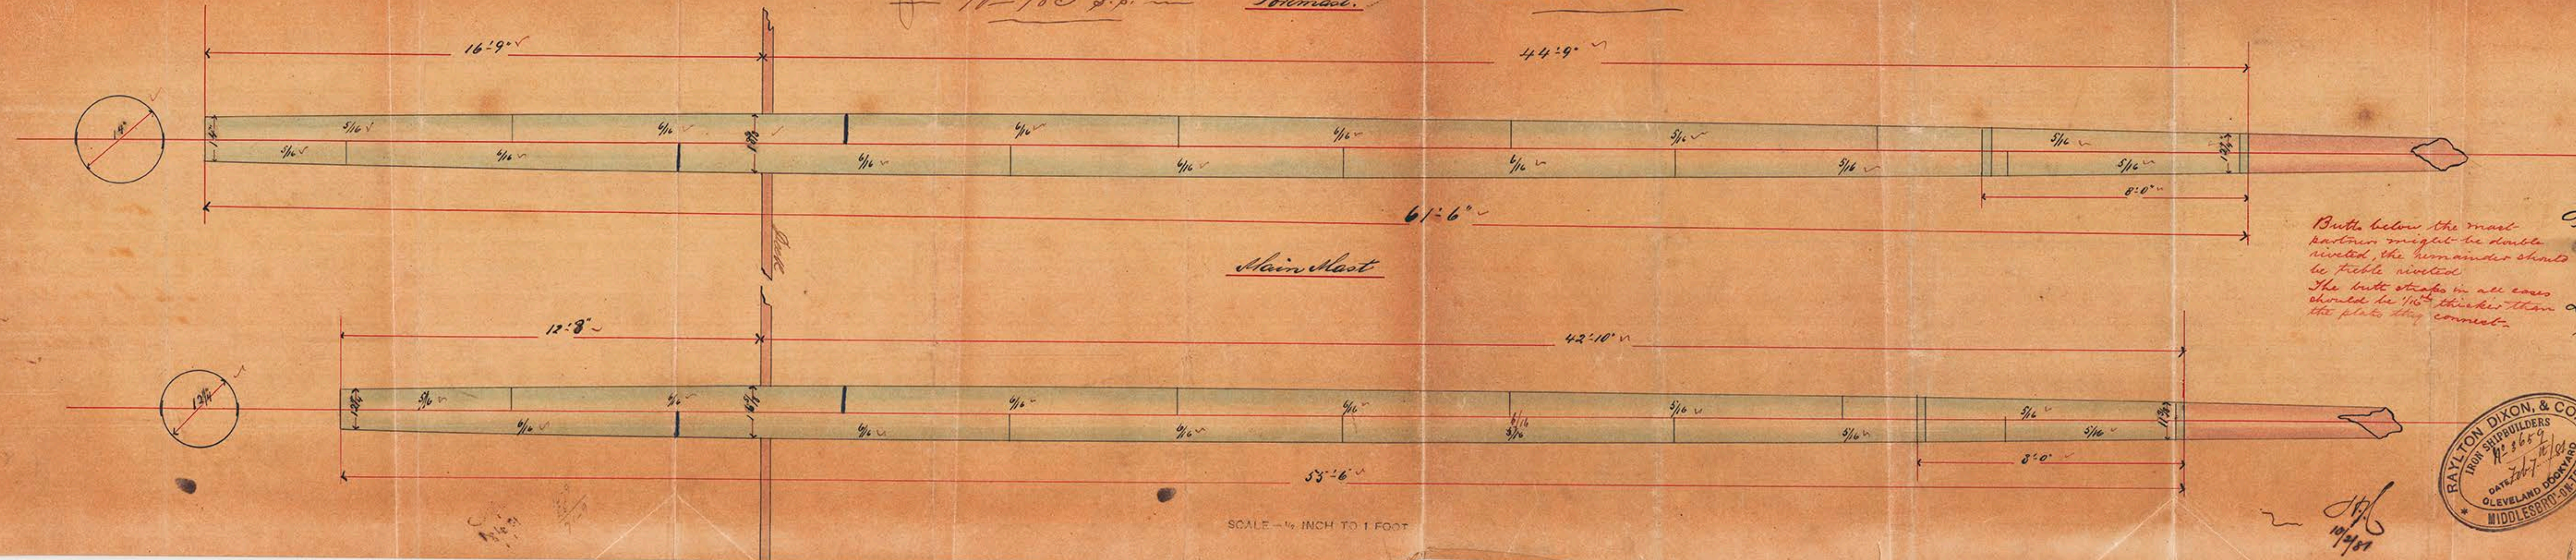

Butts below the mast  
 partner might be double  
 riveted, the remainder should  
 be triple riveted.  
 The butt straps in all cases  
 should be 1/16" thicker than  
 the plates they connect.

Butts to be double rivetted  
 except the butt above and  
 below upper deck, which  
 are to be triple rivetted.  
 Landings to be double  
 rivetted, chipped fair  
 and couked tight.



No 183. S.P.