


MIDSHIP SECTION of N^o 76 SS.

Scale 1/2 in = 1 ft

Messrs Turnbull & Son Whitby April 1881

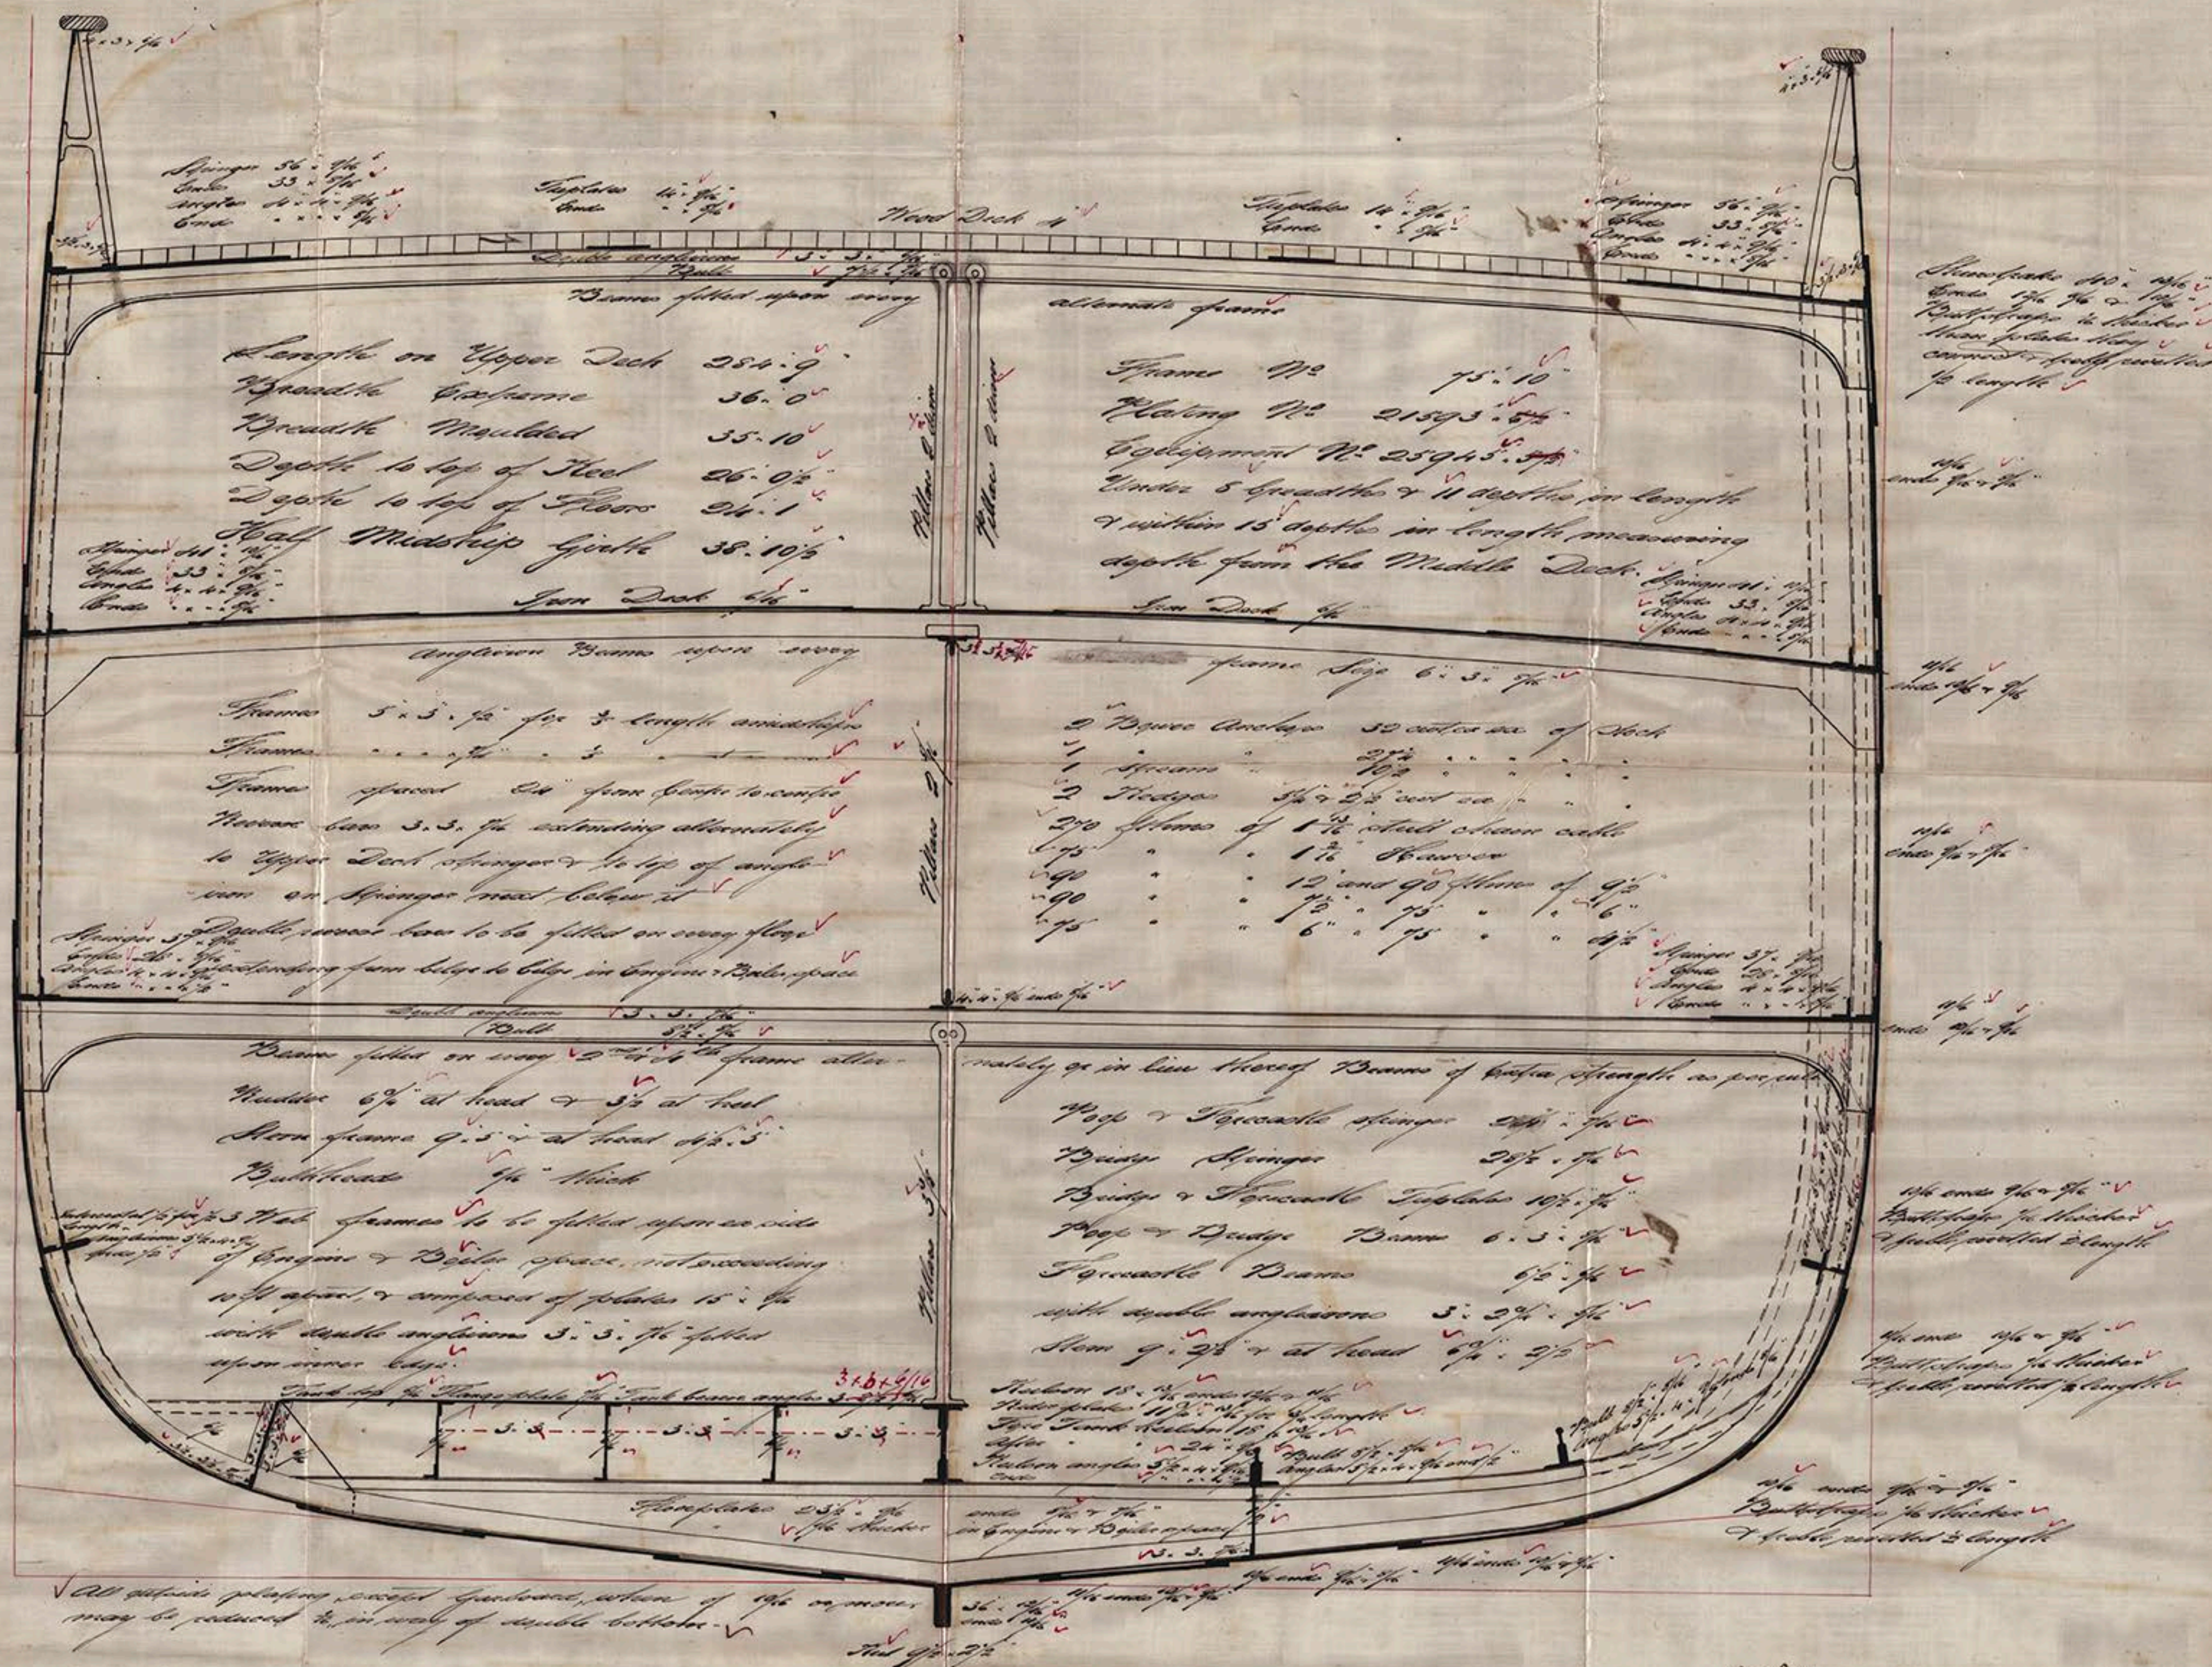

✓ All depths pleasing except Grandview, where if the m. m. may be reduced to, in view of double bottom. ✓

11/4/8