


na. b. 82

Scale $\frac{3}{4}$ in = 1 foot

MASTERS THEO TURNBULL & SON WAVERLY TOWN/81

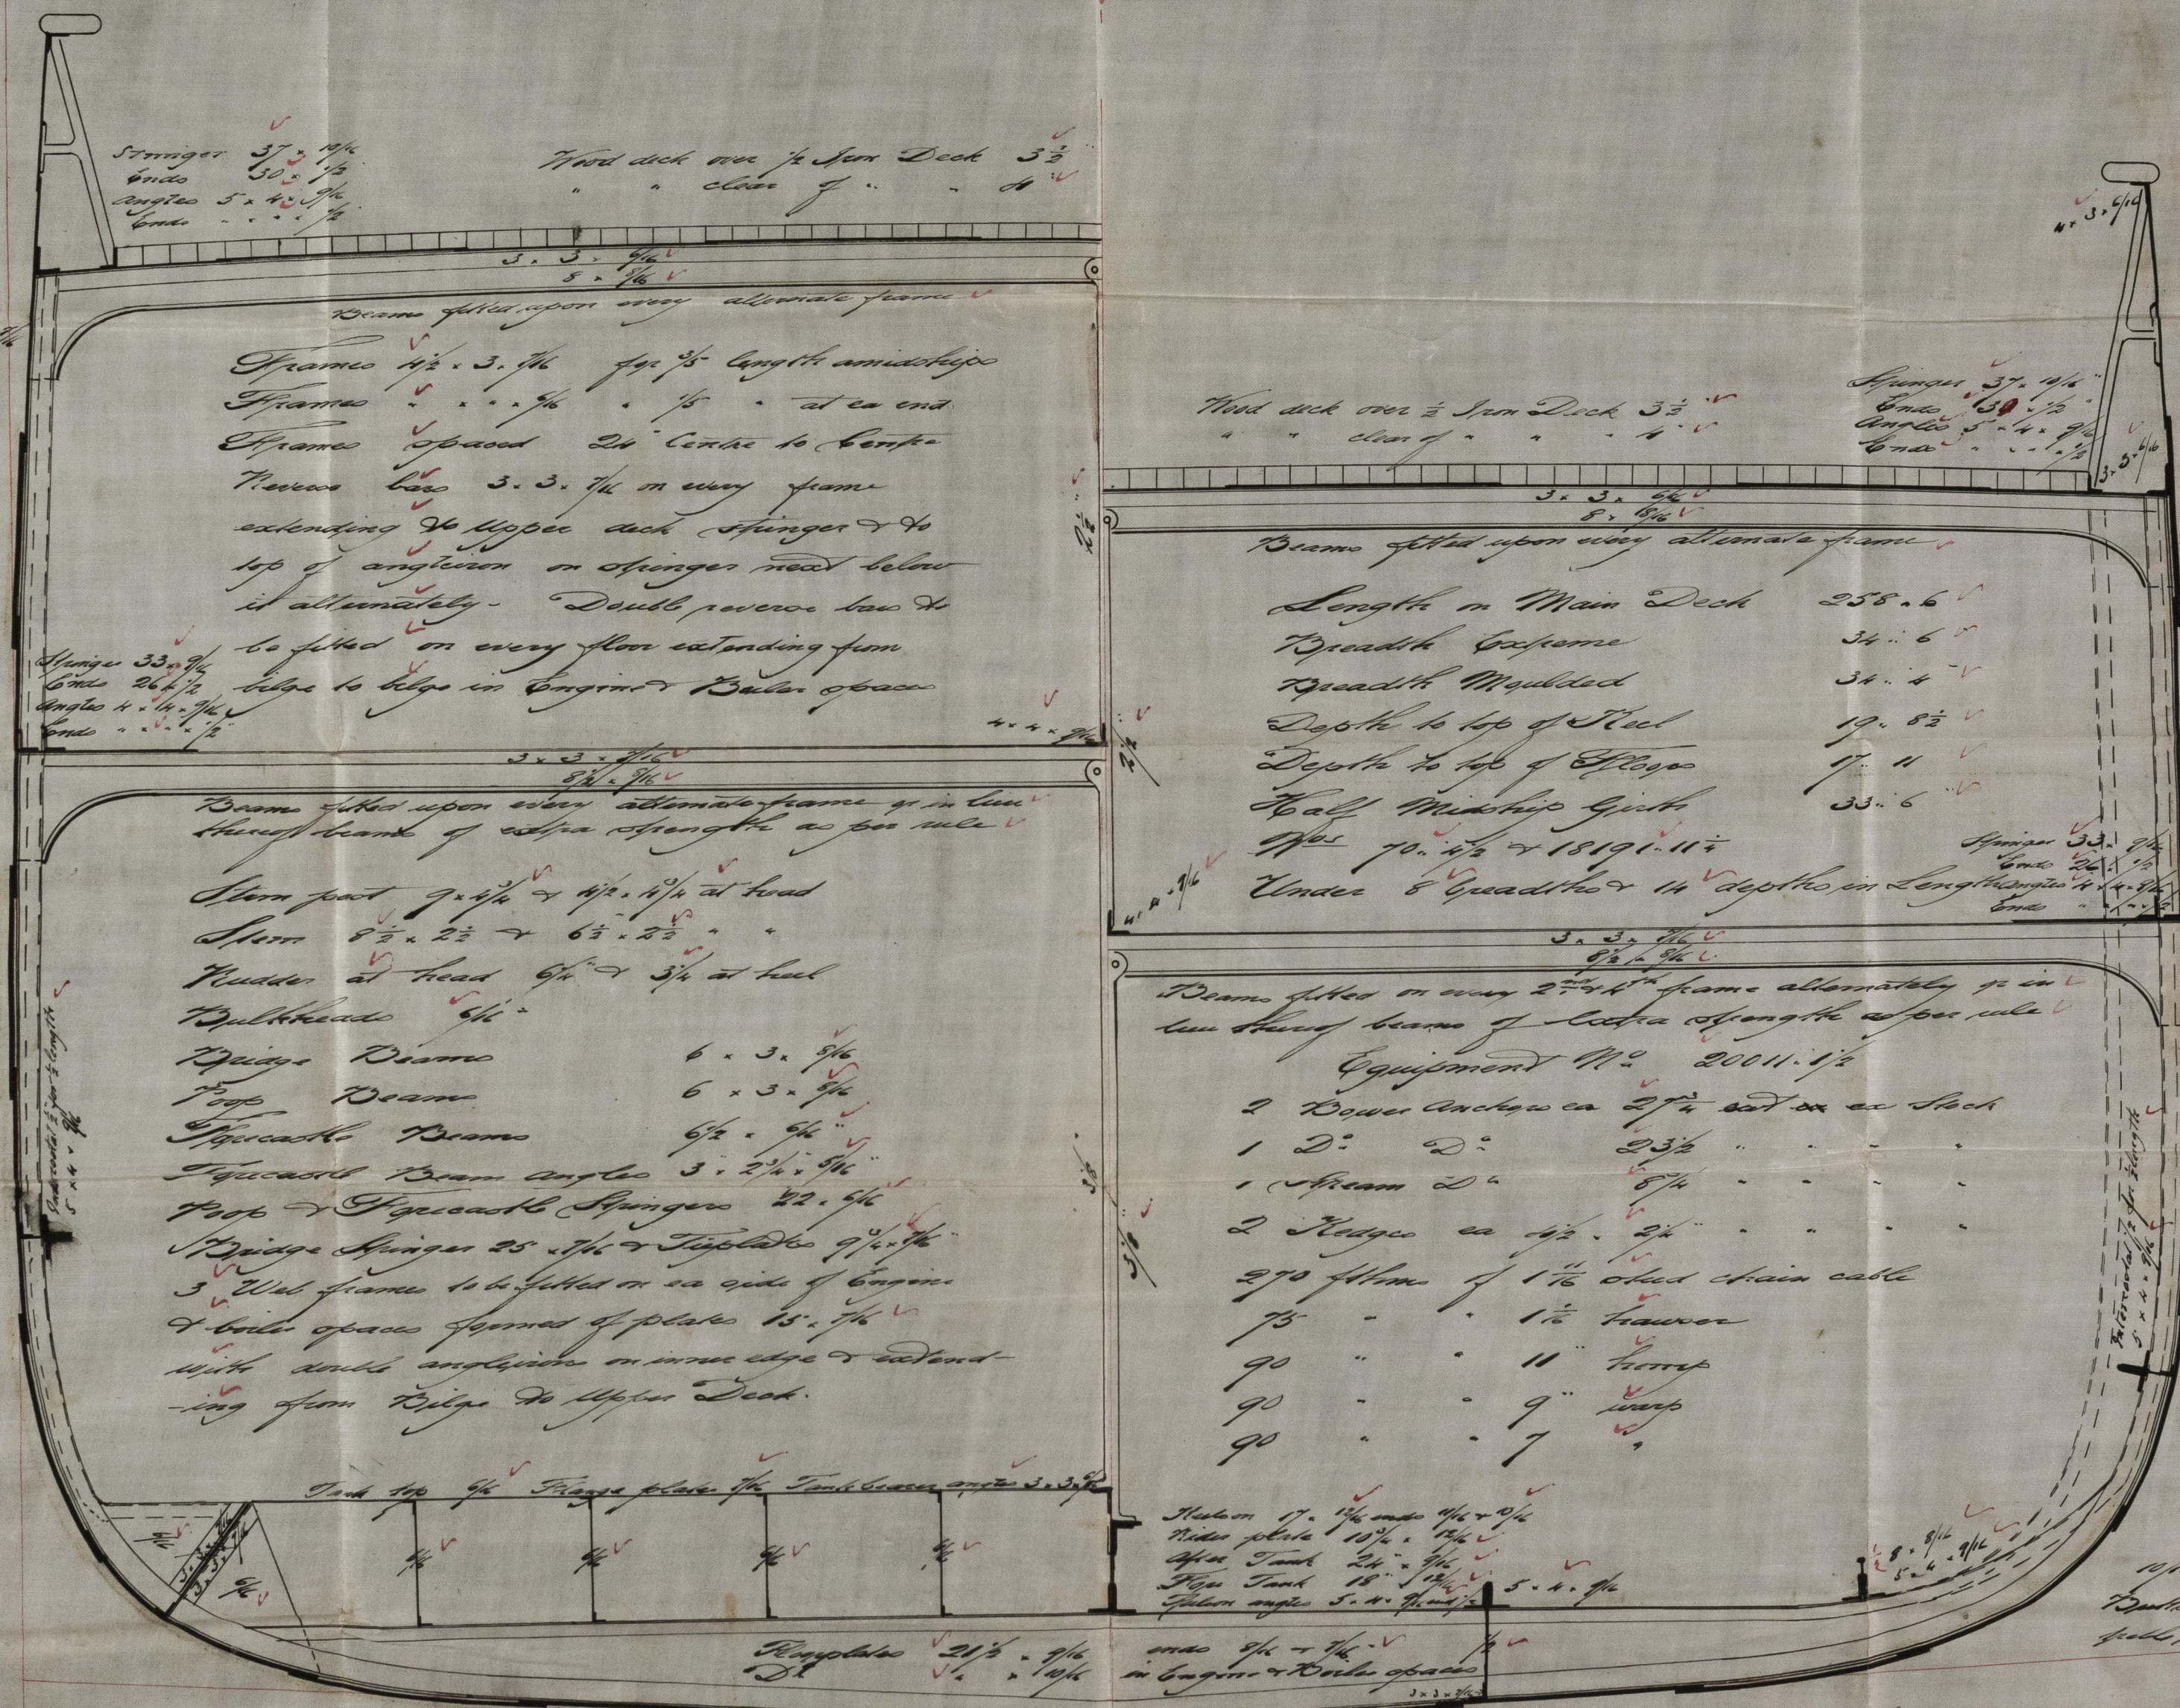

All outside relating ^{second} ^{within} ^{of} ^{the} ^{same} ^{may} ^{be} ^{reduced} ^{to} ⁱⁿ ^{any} ^{of} ^{these} ^{books} -

Shankake 40. $12\frac{1}{2}$ ✓
 Ends $4\frac{1}{2}$ $10\frac{1}{2}$ $7\frac{1}{2}$ ✓
 Shankake doubled ✓
 Below stronger for ✓
 $3\frac{1}{2}$ length in armature ✓

10/6 ends ✓
9/6 + 8/6 ✓

$$\frac{10/16 \text{ and } 8/16}{2} \cdot 2$$

~~10/6 and 9/6 + 8/6~~ ✓

10% under 9% $\frac{1}{2}$ ✓
Buttopape to thicker ✓
✓ full, rivited 3 ✓
length ——— ✓

10/16 ends $\frac{1}{16}$ & $\frac{1}{16}$ ✓
Buckstages to finish ✓
well finished & length ✓

29/6/81 18m