


Ltr. to West Hartlepool
8/9/82.

Seams double rivetted - laps $3\frac{3}{4}$ - $5\frac{1}{8}$ rivets

Housing 24.5

Butts double below Mast
fasteners run amides treble
+ $\frac{1}{16}$ thicker

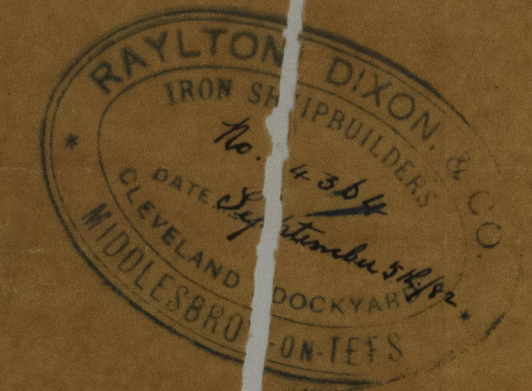

Seams double rivetted - laps $3\frac{3}{4}$ - $3\frac{3}{8}$ rivets

Housing 15.4

S.S. N° 209 S. S. C.

FORE MAST

Scale $\frac{1}{2} = 1$ Foot

Above deck 50.8

Extreme length 74.11

MAIN MAST

Above deck 50.8

Extreme length 65.10

Quoins Arbil West of Mast Report 10.50.74.

Head 12.0

Two plates in round.

Head 9.0

Two plates in round.

JS 6/9/82



© 2021 Lloyd's Register Foundation