


A.D. Mosser, W. Hpt. Report No. 4921.


Scantlings of Iron Masts No. 286 S.S.

Scale $\frac{1}{4}'' = 1$ Foot.


Fore Mast.

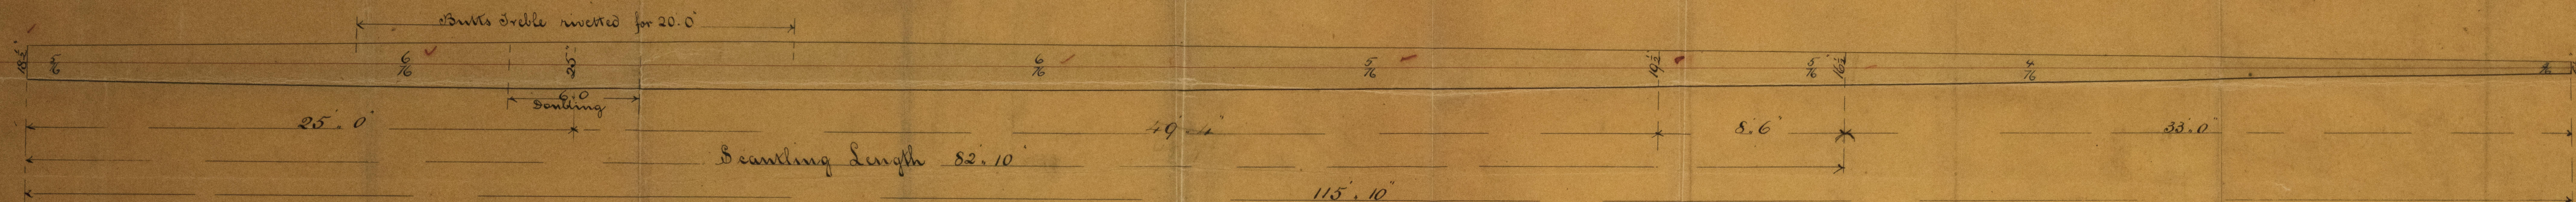

Main Mast

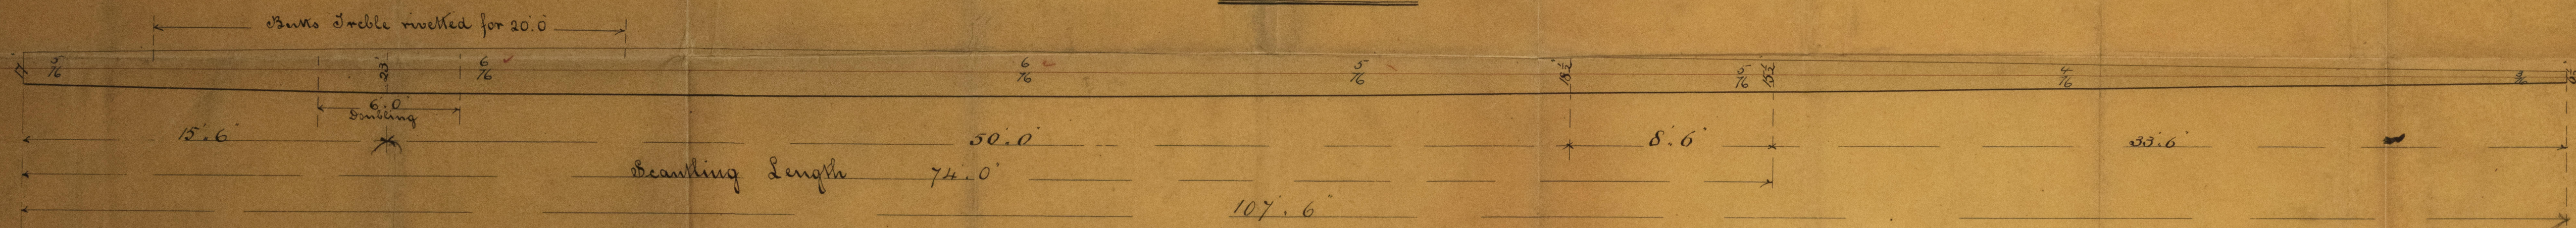

Mizzen Mast

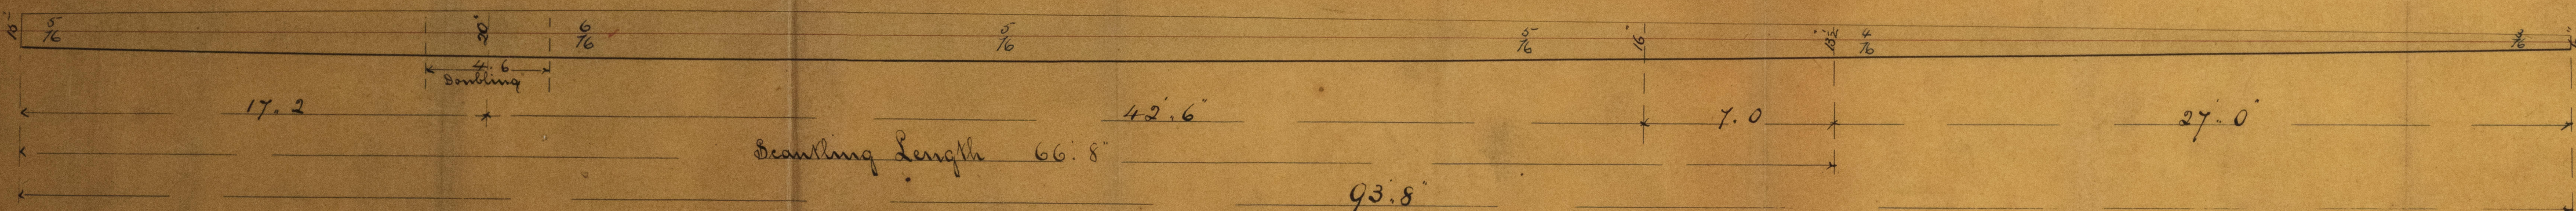

Remarks

Butts to be single rivetted
Butts in all Masts to be double
except where marked treble
Ships same thickness as connecting plates
Angle iron Stiffeners $3 \times 3 \times \frac{3}{8}$ in all masts
and carried as far as practicable

STK 905-0148

W. Hpt. Report 26/11/81

© 2021
RICHARDSON, DUCK & CO.,
Iron Ship Builders
FOCKTON-ON-TEES, ENGL.