
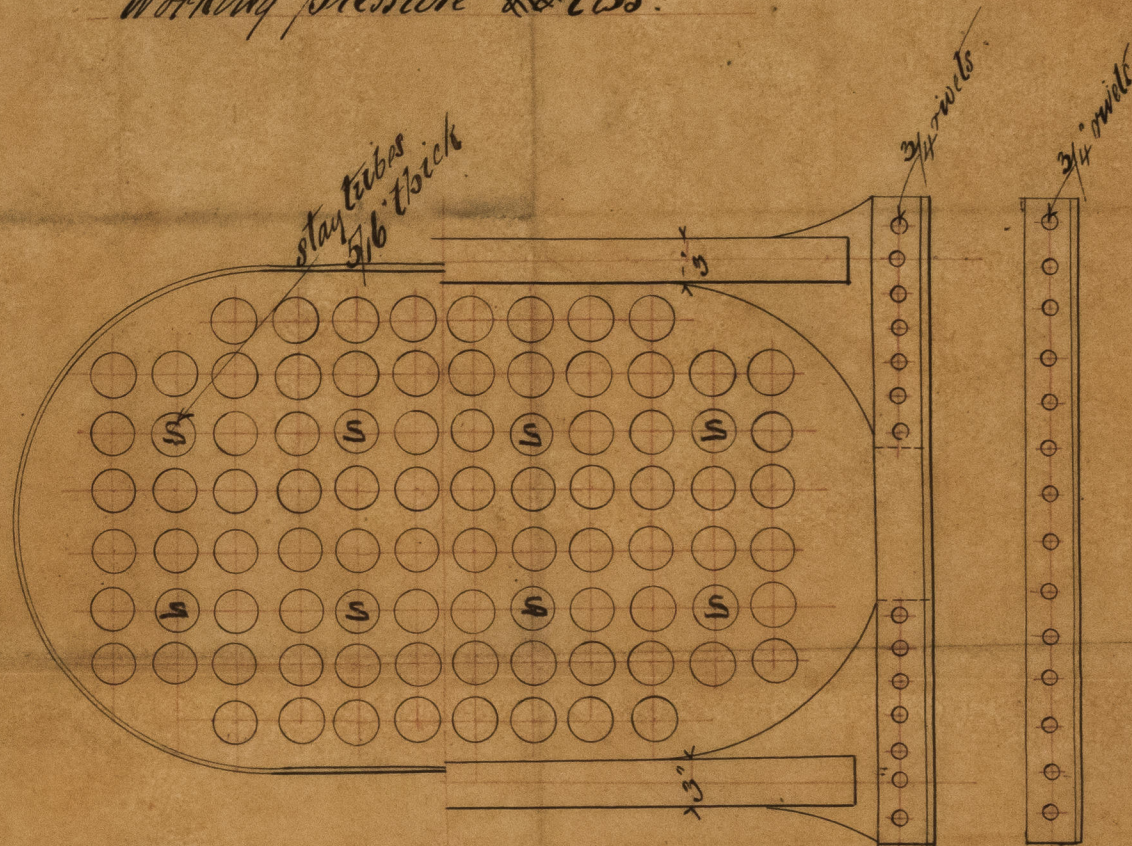


26.7.82

Riveting

long seams circular seams.

Working pressure ⁷⁵~~80~~ lbs.

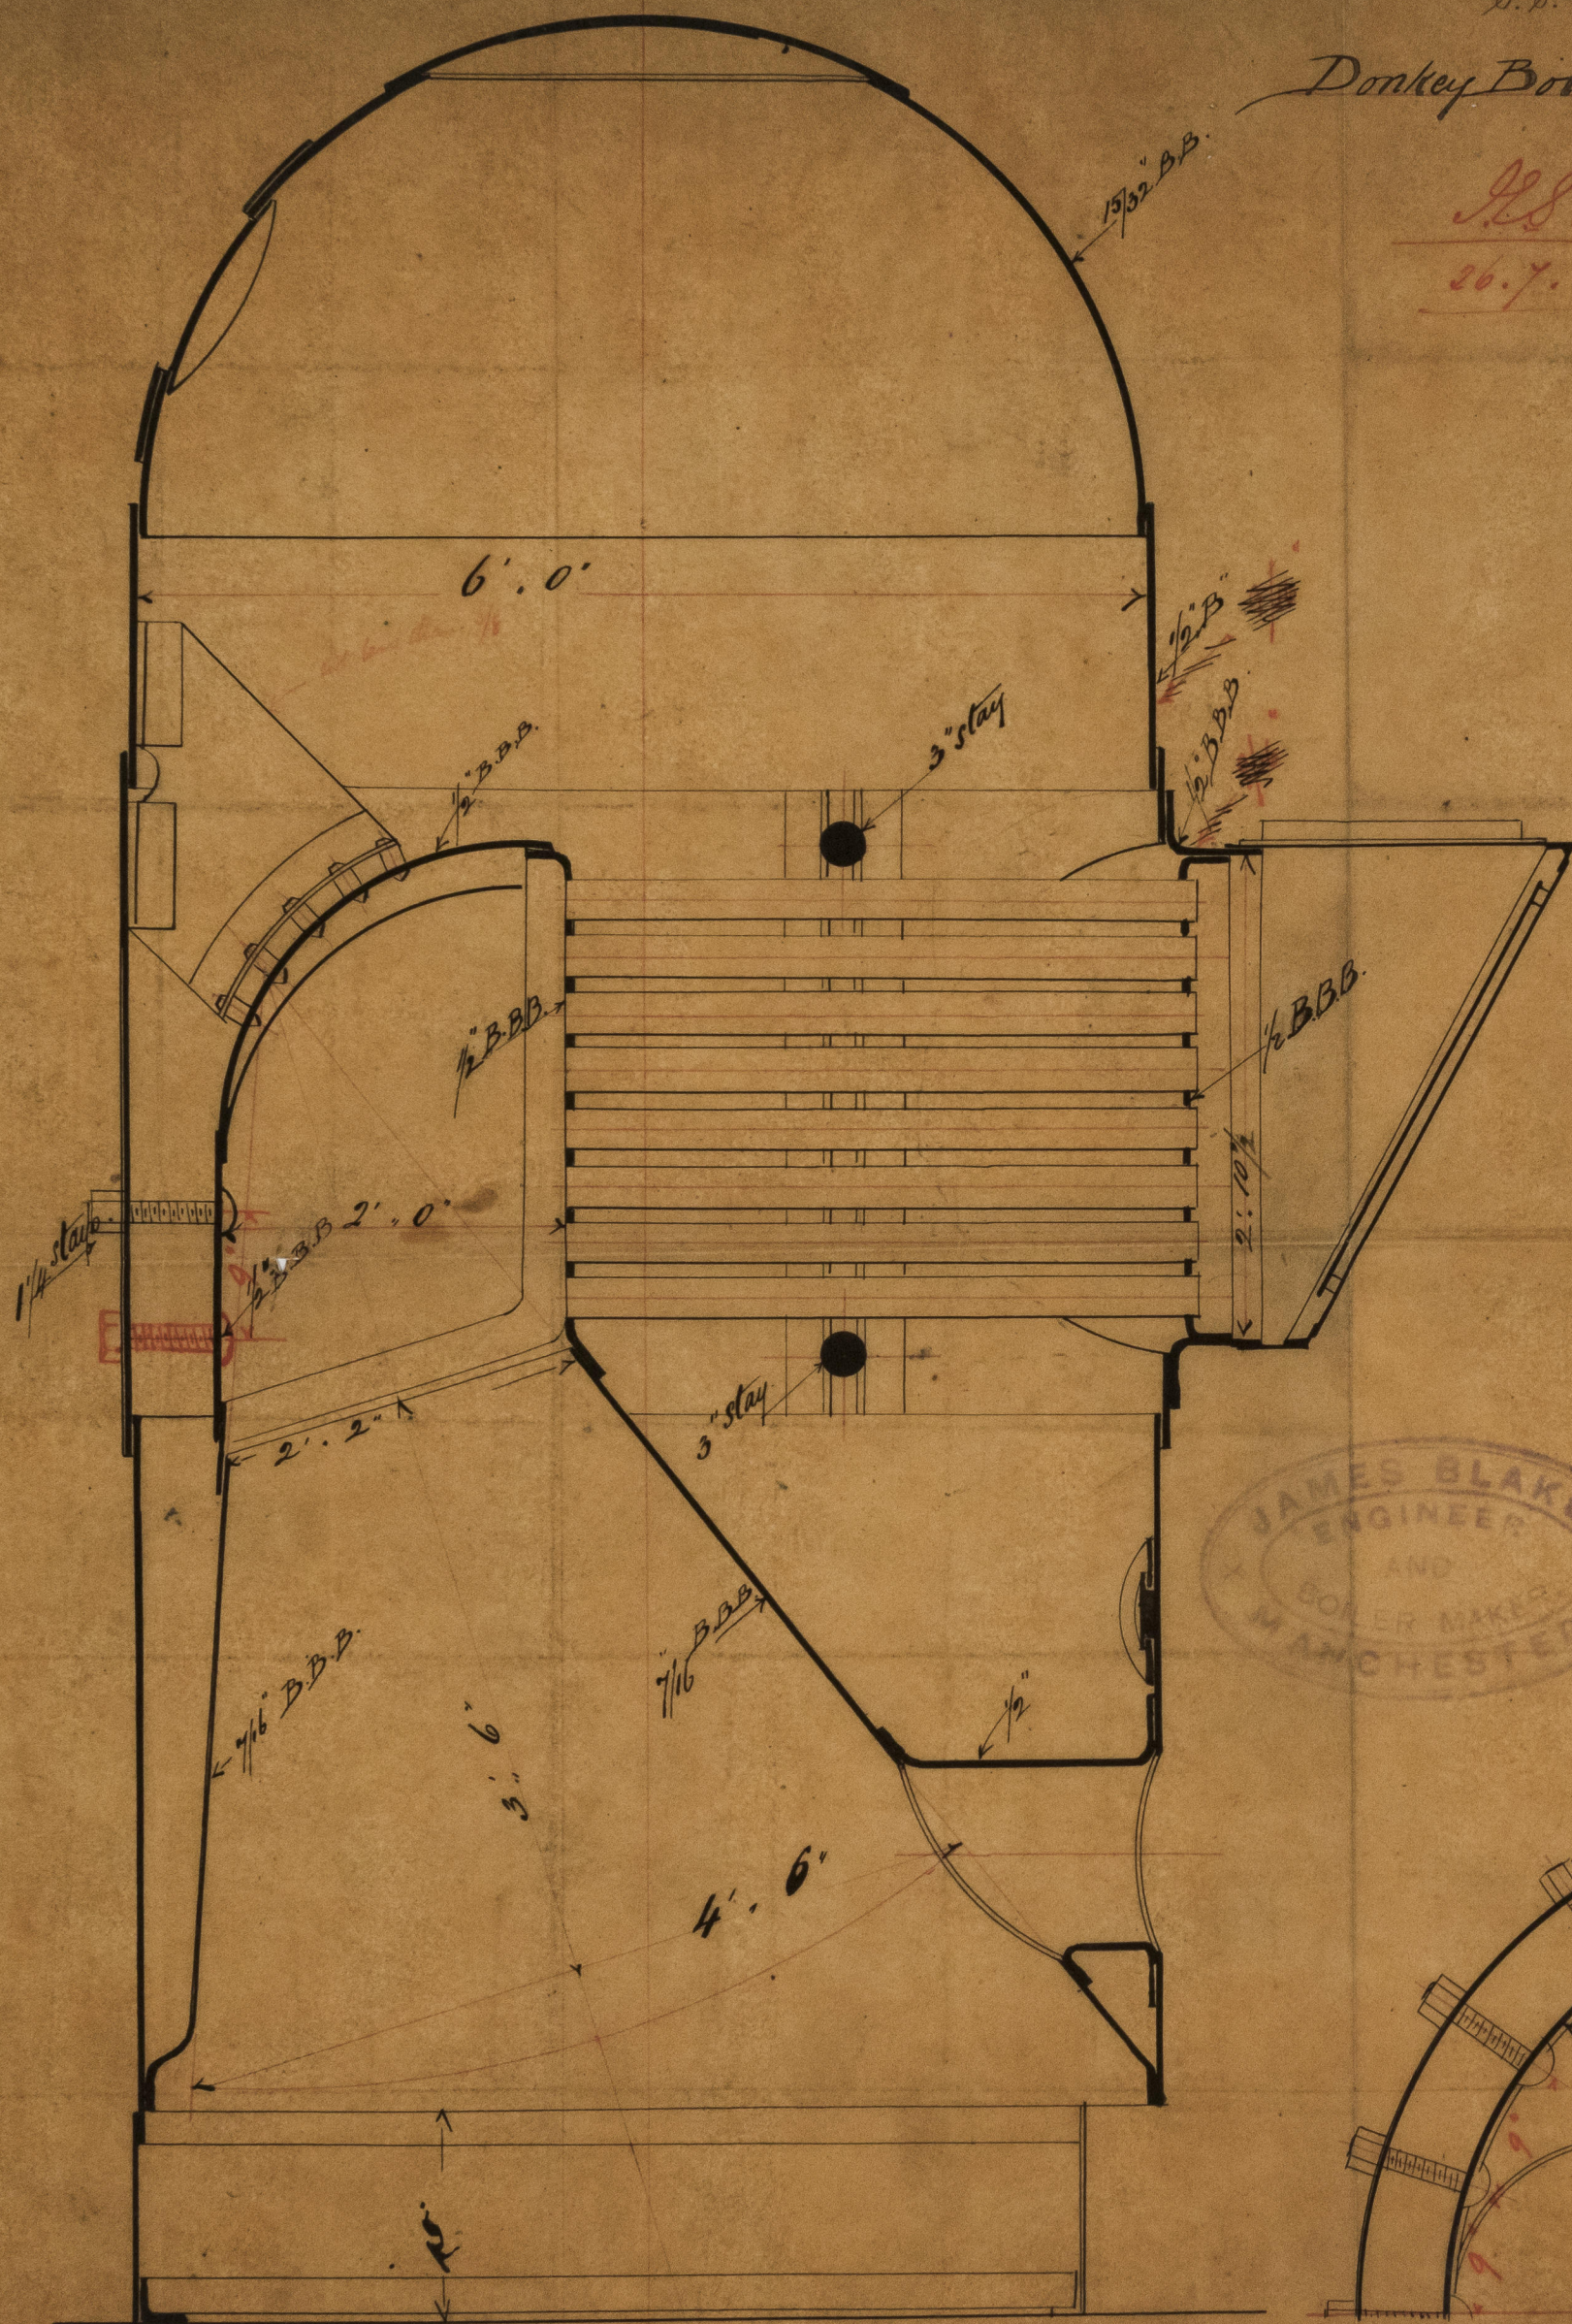

Scale 1" = 1 foot



5TK906-0106