
 


See to Hpl 3/1/82


H. H. Howard Reaband, Jr. Hpl. Report No. 5004.

PUMPING ARRANGEMENT S.S N° 207

Scale: 1/4" = 1 Foot.

 

30/6/82
J.S.

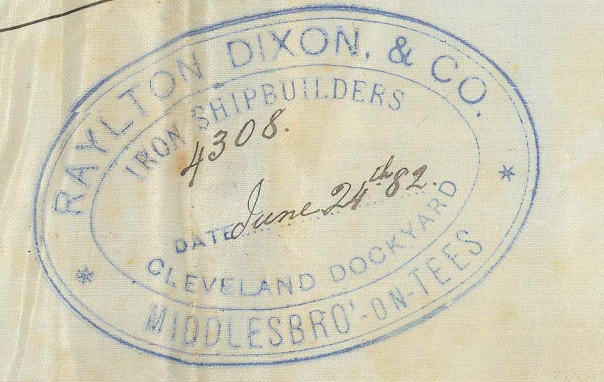

725
Ballast Banks

See

STX906-0107



© 2021

Lloyd's Register
Foundation