



Let. to W. Hops 15/2/82.

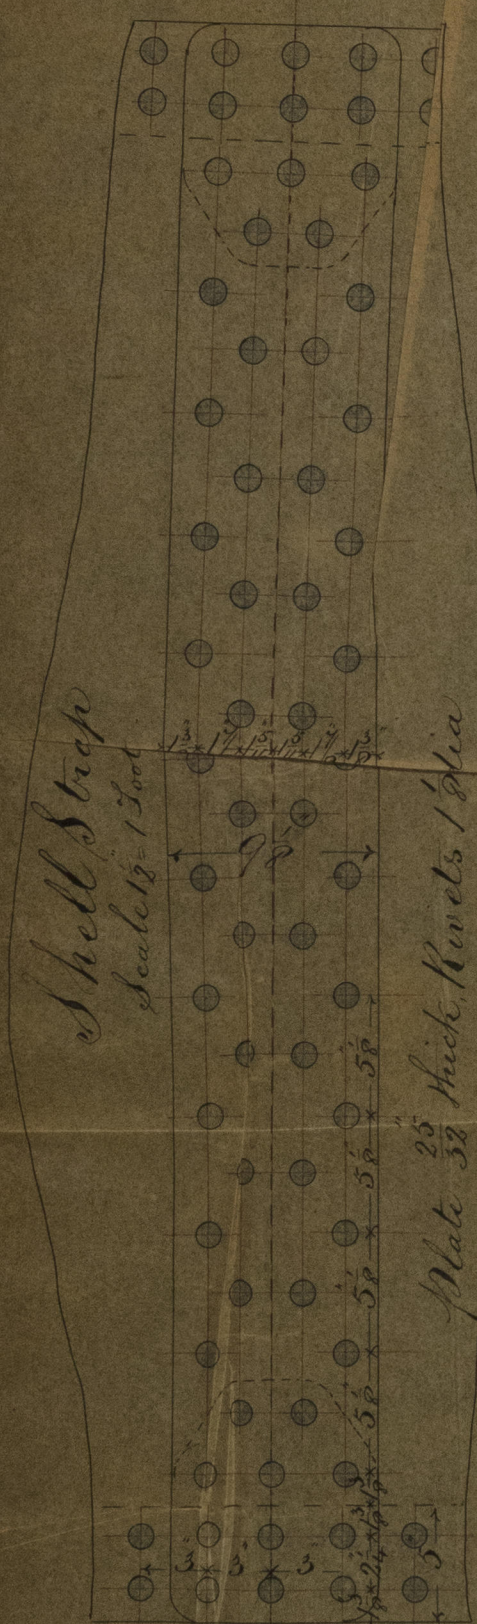


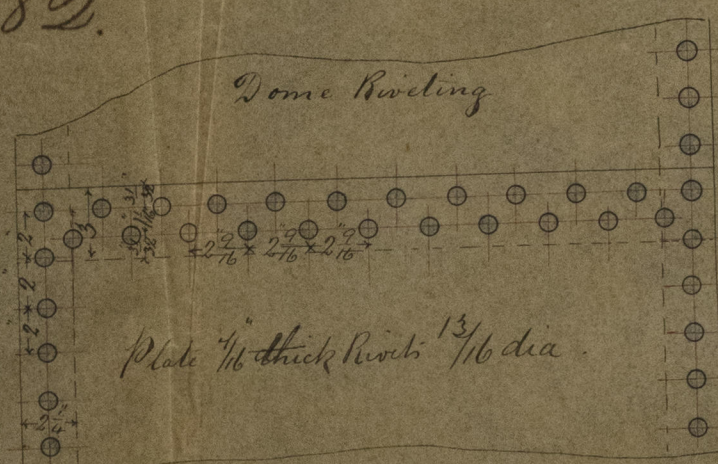



# BOILER N<sup>o</sup> 729.

For S.S. N<sup>o</sup> 291 building by Messrs Richardson & Duck 7C.  
Scale 1" = 1' 0"

Working pressure 85 lbs per sq inch.

Feb 9 1882

263

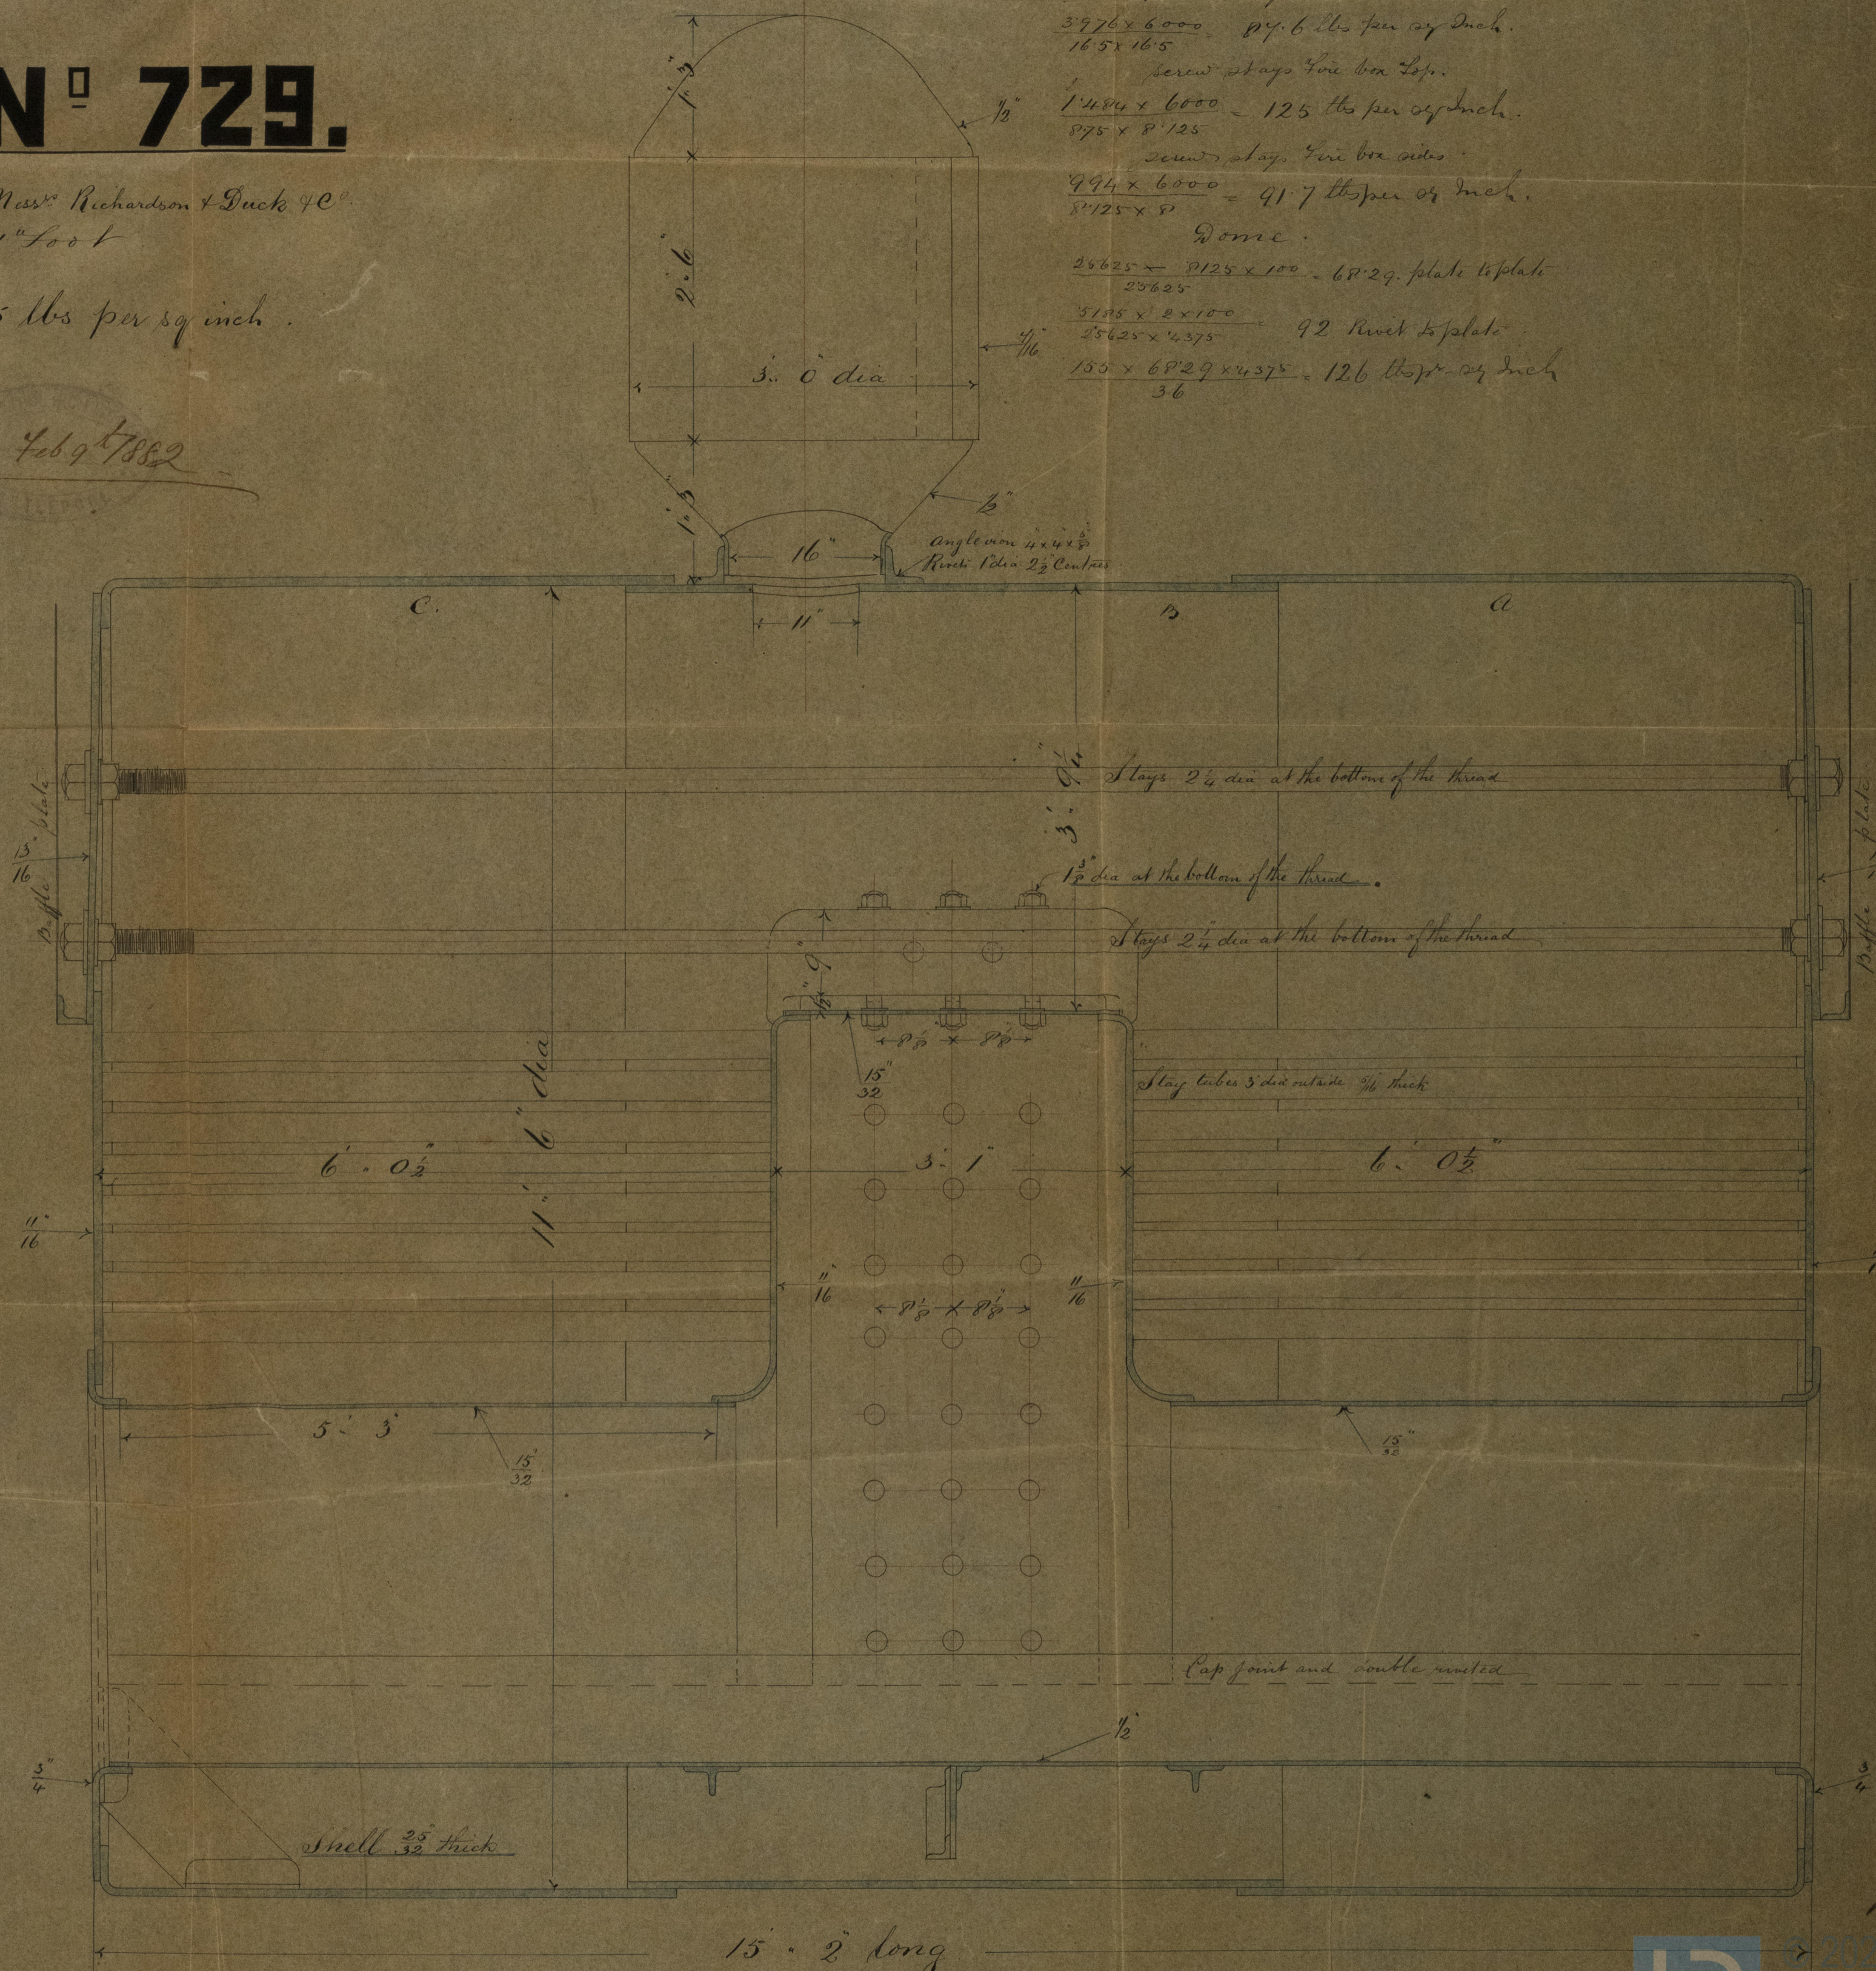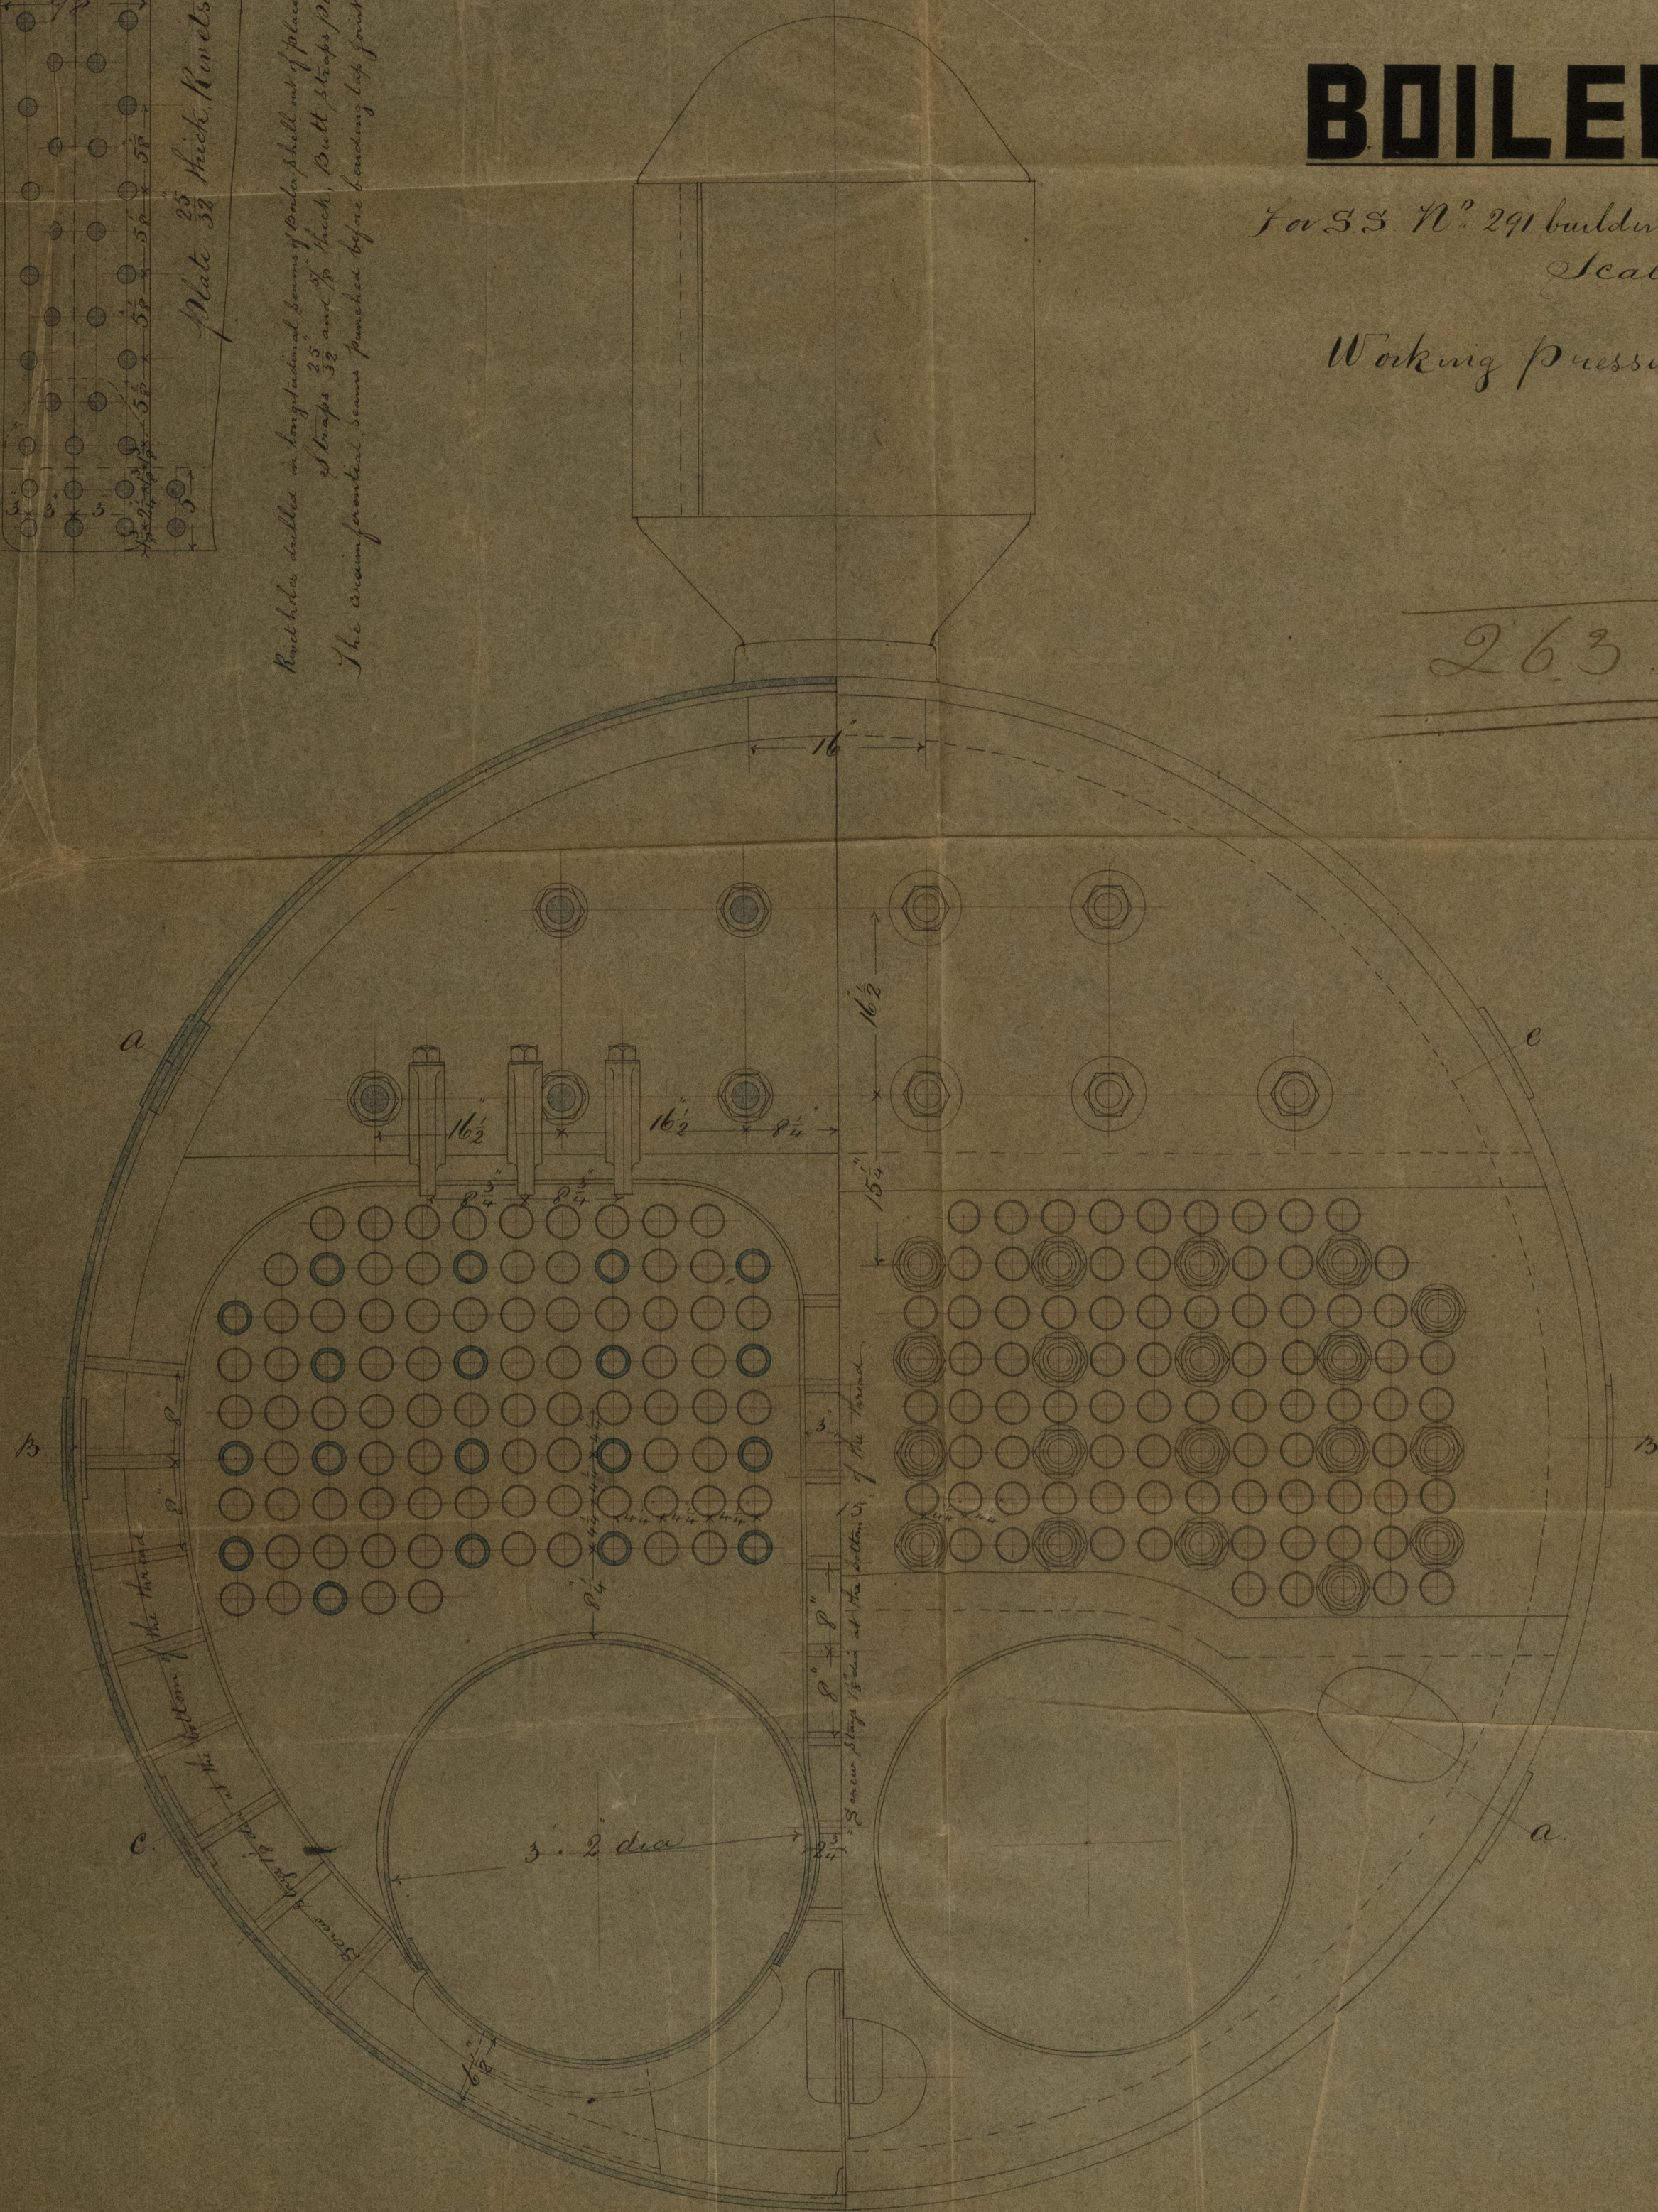

**Calculations**  
 Shell  
 Furnaces  
 $15'2 \times 8'9600 = 96$  lbs per sq inch  
 $5'23 \times 3'9 = 20'6$  lbs per sq inch  
 Fire box sides  
 $4'5 \times 1'100 = 4'95$  lbs per sq inch  
 $4'125 \times 1'100 = 4'5$  lbs per sq inch  
 Fire box top  
 $4'5 \times 1'100 = 4'95$  lbs per sq inch  
 $4'125 \times 1'100 = 4'5$  lbs per sq inch  
 End plates  
 $13'2 \times 14'0 = 18'4$  lbs per sq inch  
 $16'5 \times 16'5 = 27'2$  lbs per sq inch  
 Main stays  
 $3'76 \times 6'000 = 22'5$  lbs per sq inch  
 $16'5 \times 16'5 = 27'2$  lbs per sq inch  
 Screw stays fire box top  
 $1'404 \times 6'000 = 8'4$  lbs per sq inch  
 $8'75 \times 8'125 = 71'2$  lbs per sq inch  
 Screw stays fire box sides  
 $4'94 \times 6'000 = 29'6$  lbs per sq inch  
 $8'125 \times 8'125 = 66'0$  lbs per sq inch  
 Dome  
 $1'50 \times 6'229 \times 4'27 = 4'0$  lbs per sq inch  
 $3'6$