

RECEIVED 21 APR 82



St Mark, N Hope Report No 5012

# Scantling of Iron Masts

Scale 1/4" = 1 foot



291

## Fore Mast

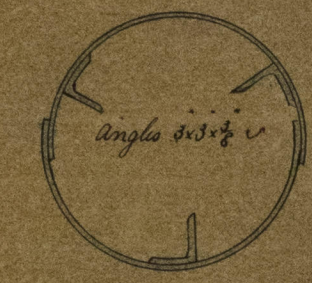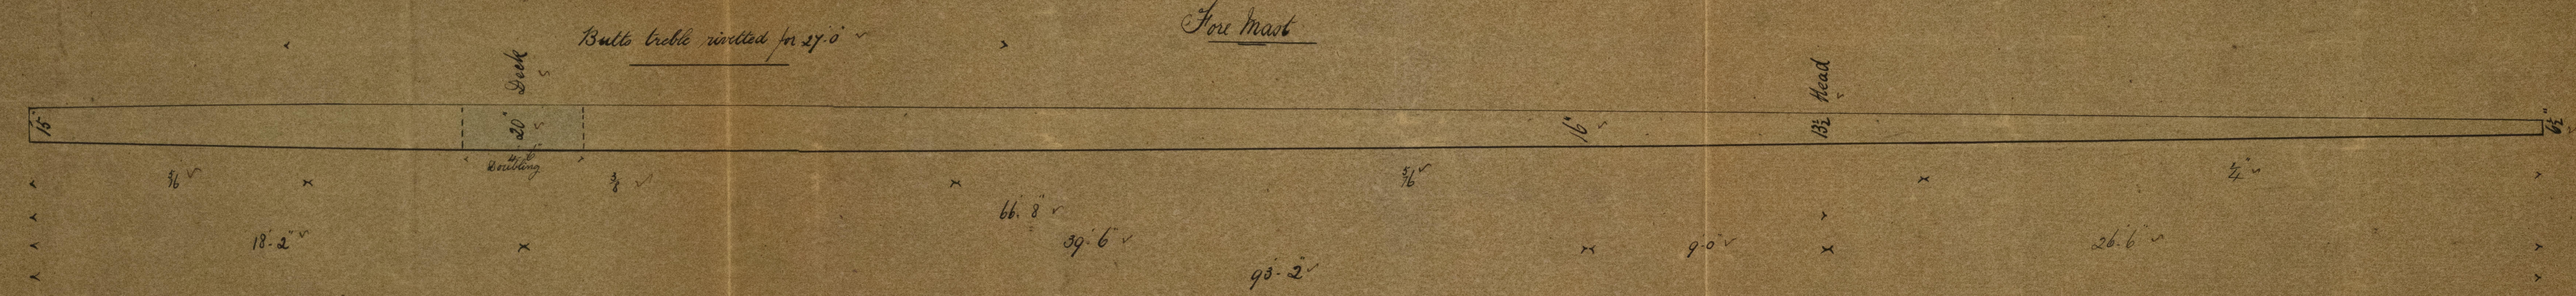

Remarks.  
Butts double riveted except where marked treble ~  
Seams single riveted 23" lap ~  
Angles three in number running as near the whole length ~  
as practicable  
Plates 9 ft long butts shifted 4'-6" ~  
Straps 10" for double & 15" for treble riveting ~  
Rivets 3/4" all flush outside ~  
Butts straps inside to be 1/8" thicker than plates ~  
they connect where treble riveted ~


## Main Mast

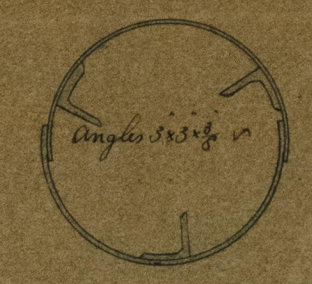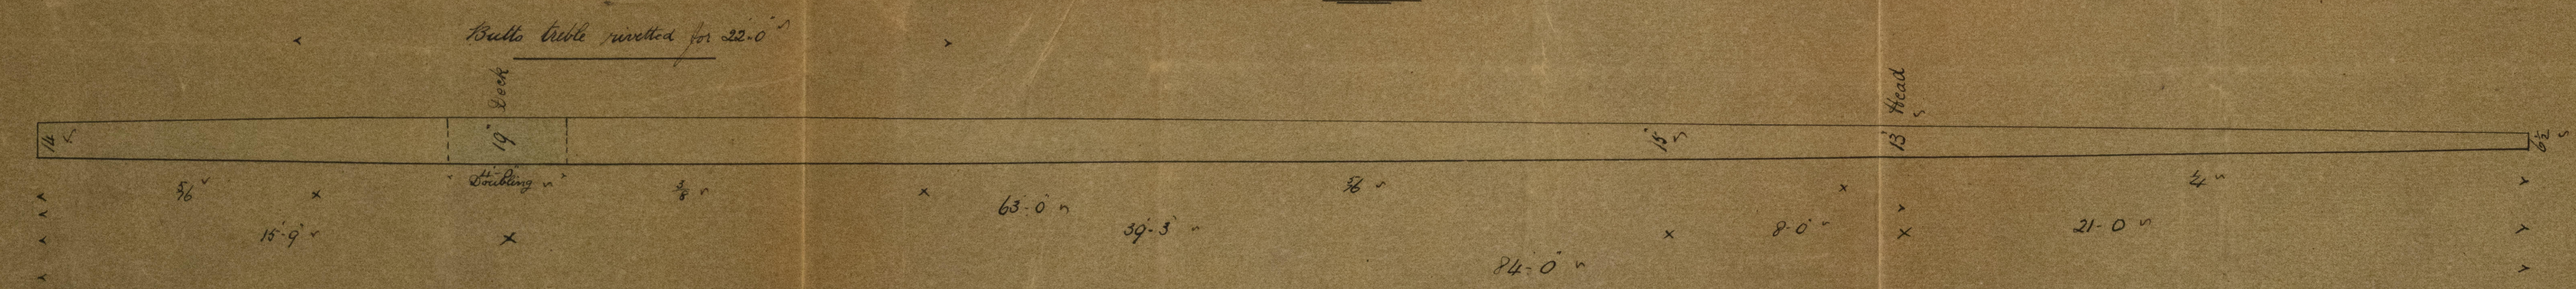

Nº 291

RICHARDSON, DUCK & CO.,  
Iron Ship Builders

TOCKTON-ON-TEES

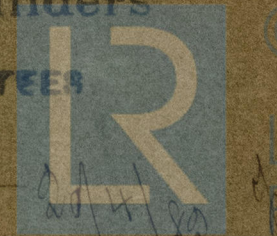

© 2021

Lloyd's Register  
Foundation

18/4/82  
21/4/82

18/4/82