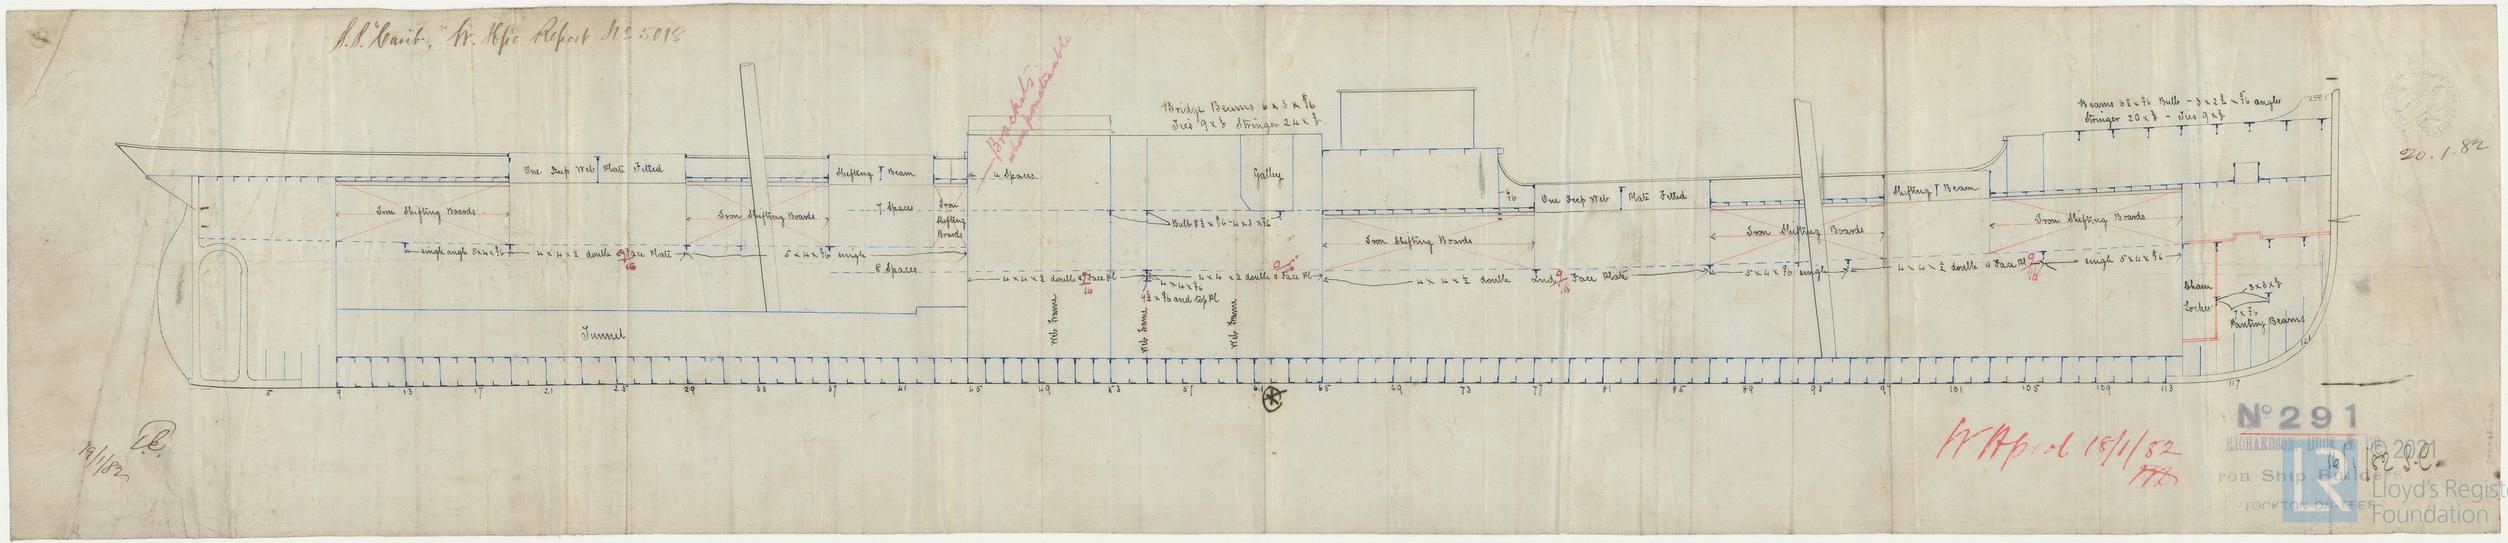
S.S. "Carit," W. Hfc Report No 5018
Brackets unimportantable
Bridge Beams 6 x 3 x 5/16
Ties 9 x 3/8 Stringer 24 x 3/8
Beams 6 1/2 x 5/16 Bulb - 3 x 2 3/4 x 5/16 angle
Stringer 20 x 3/8 - Ties 9 x 3/8
One Deep Web Plate Fitted
Shifting Beam
Iron Shifting Boards
Galley
Tunnel
Web Frame
Sham Locker
Panting Beams
20.1.82
19/1/82
W Approl 18/1/82
No 291
RICHARDSON, DUCK & CO
Iron Ship Builders
STOCKTON-ON-TEES
16/1/82 P.C.
© 2021
Lloyd's Register Foundation