

A.S. Cant, Jr. Rpt. Report 405018.

# Principal Dimensions.

LENGTH OVER ALL	Do. B.P.	245.0
BREADTH extreme	Do. MOULDED	34.0
DEPTH IN HOLD	Do. NET	18.0 (as per Rule)
TONNAGE, GROSS		19.13

Class 100 A1 Shipyards

## Scantling Numbers

Half Breadth	16-103
Depth	19-92
Half Girth	33-8
Number for Frames	70-4
Number for Plating	17130
Equipment Number	18843


Proportions  
Length to Breadth 7.1  
Length to Depth 12.5

Length 245.0  
1.5  
246.5

## Amended sketch of midship section

### Equipment

1 Bower	253	cut steel stock
1 do	253	
1 do	213	
1 Stream	83	
1 Hedge	43	
1 do	23	
270 Batches	176	stud chain balls
75 do	1	Stream chain
90 do	10	Spigots
90 do	83	Hawser
90 do	6	Marp

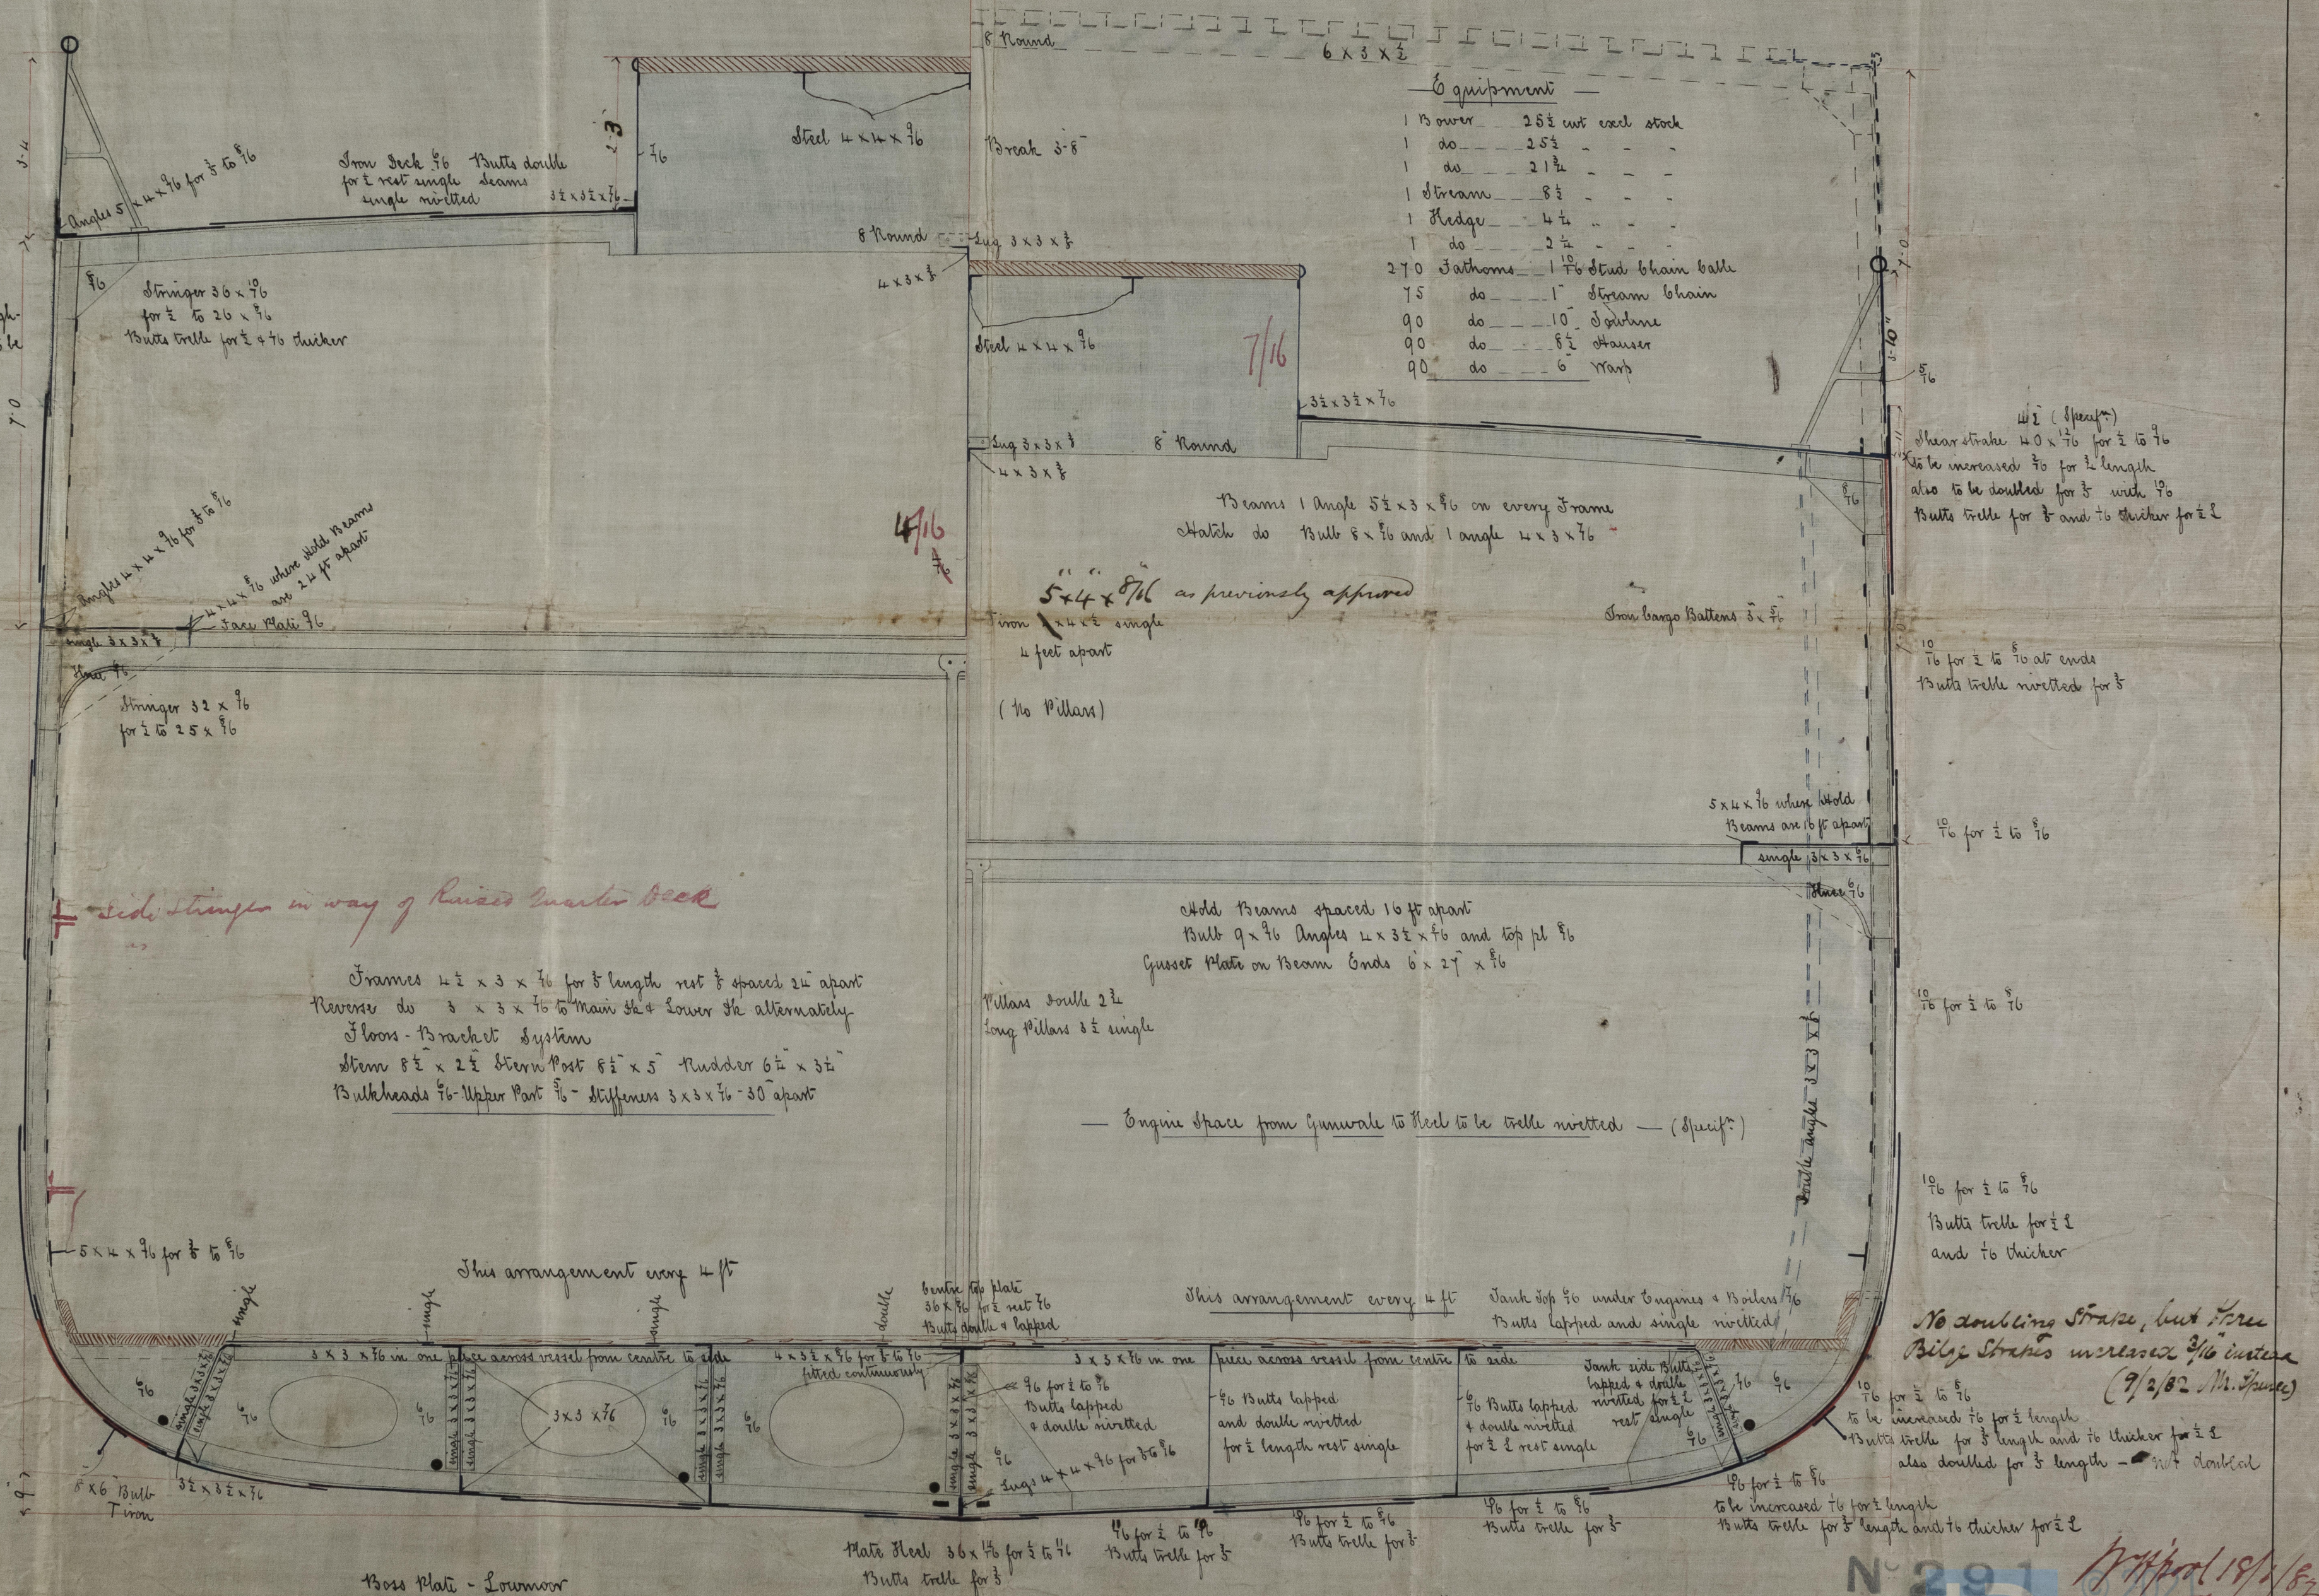




162

1/52

80.1.85

STK906-0148

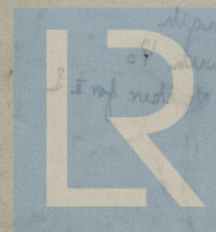

© 2021

Lloyd's Register Foundation