

RECEIVED IN SEP. 82

S.S. "Solina," W. W. H. Report No. 5065.


*Dr. L. W. Hill.
4/9/82*

*W. W. H.
4/9/82*


PUMPING ARRANGEMENT

OF

N^o 30 S S

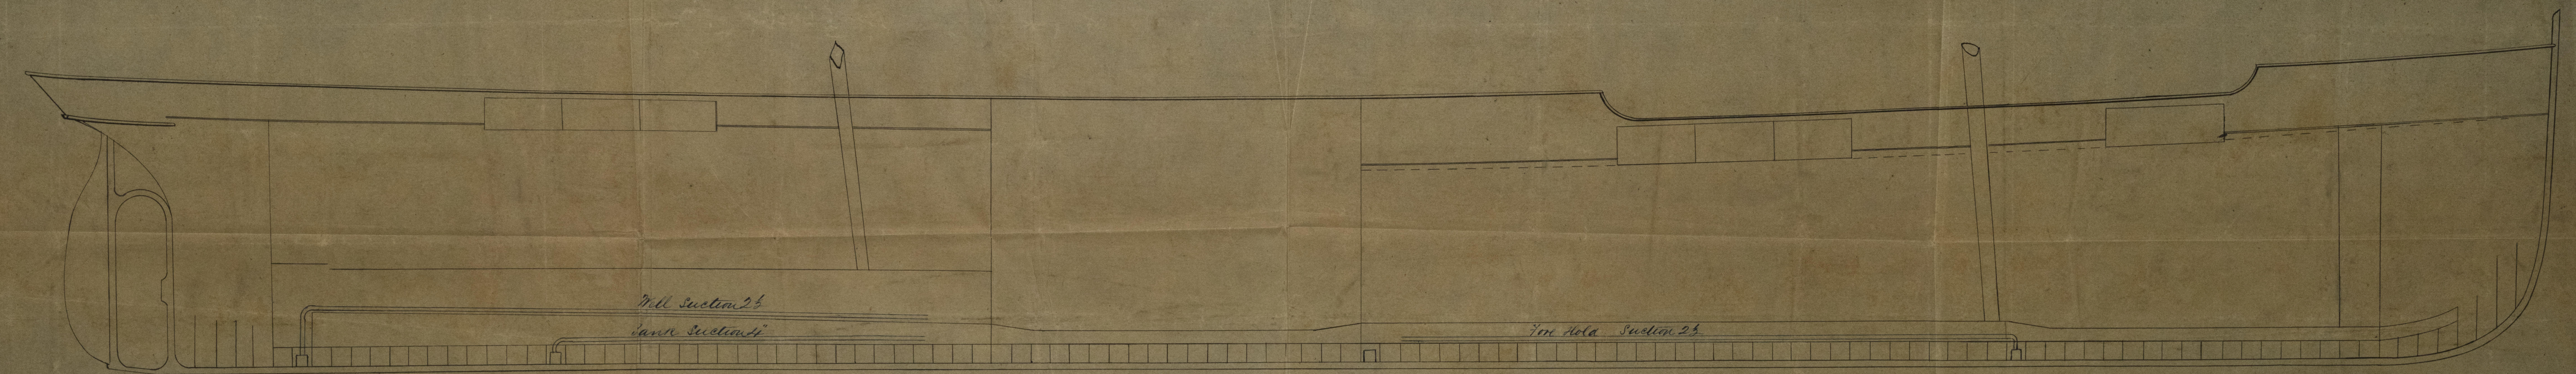

SCALE 1/4 INCH TO ONE FOOT

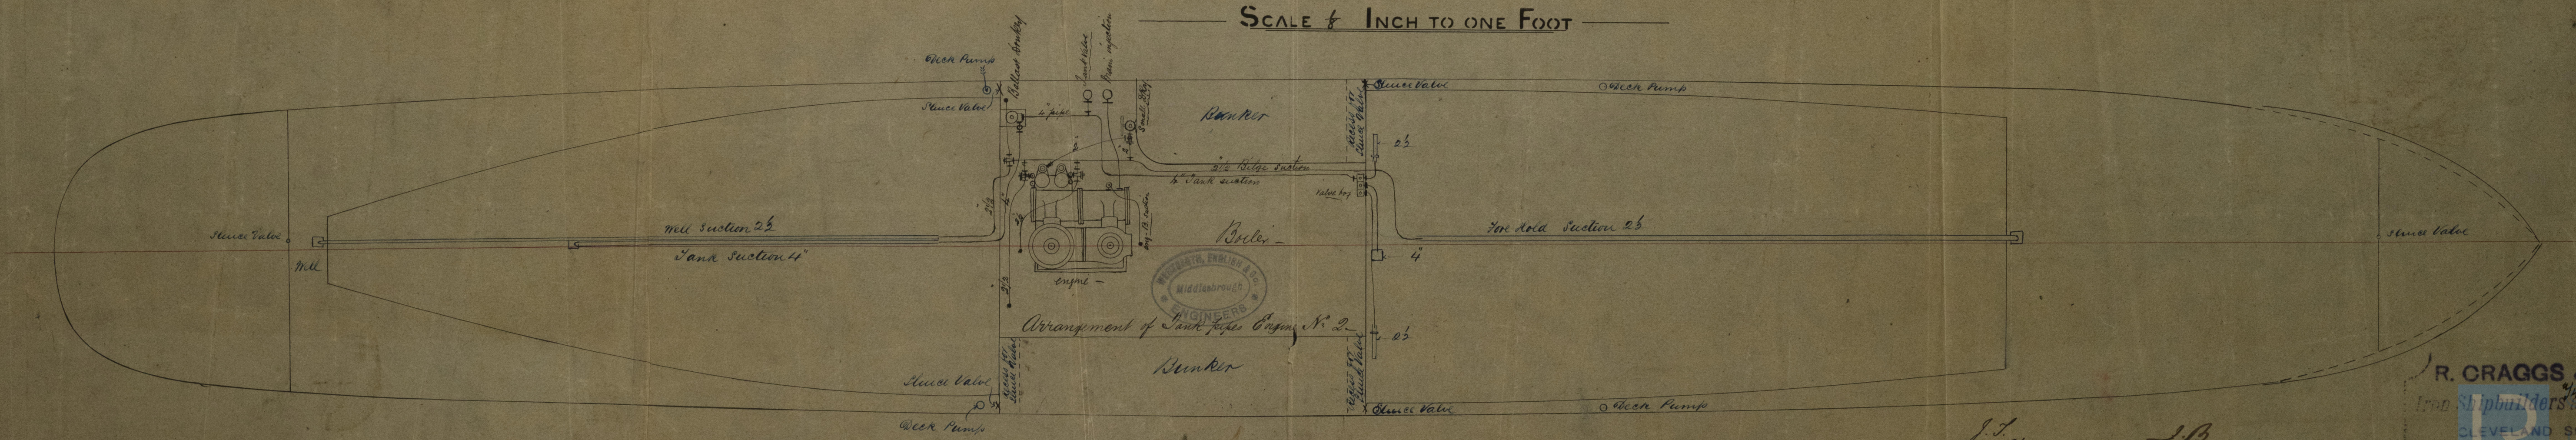

J. J. 2/9/82

*J. B.
17.4.82
2.9.82*

R. CRAGGS & SONS
Iron Shipbuilders and Engineers
CLEVELAND SLIPWAYS
MIDLESBRO
9/8/82