


20.12.87

A.S. Godiva, W. Hpl. Report No 5065

ELEVATION  
OF  
N° 30 S S  
Scale 1/4 inch = one foot

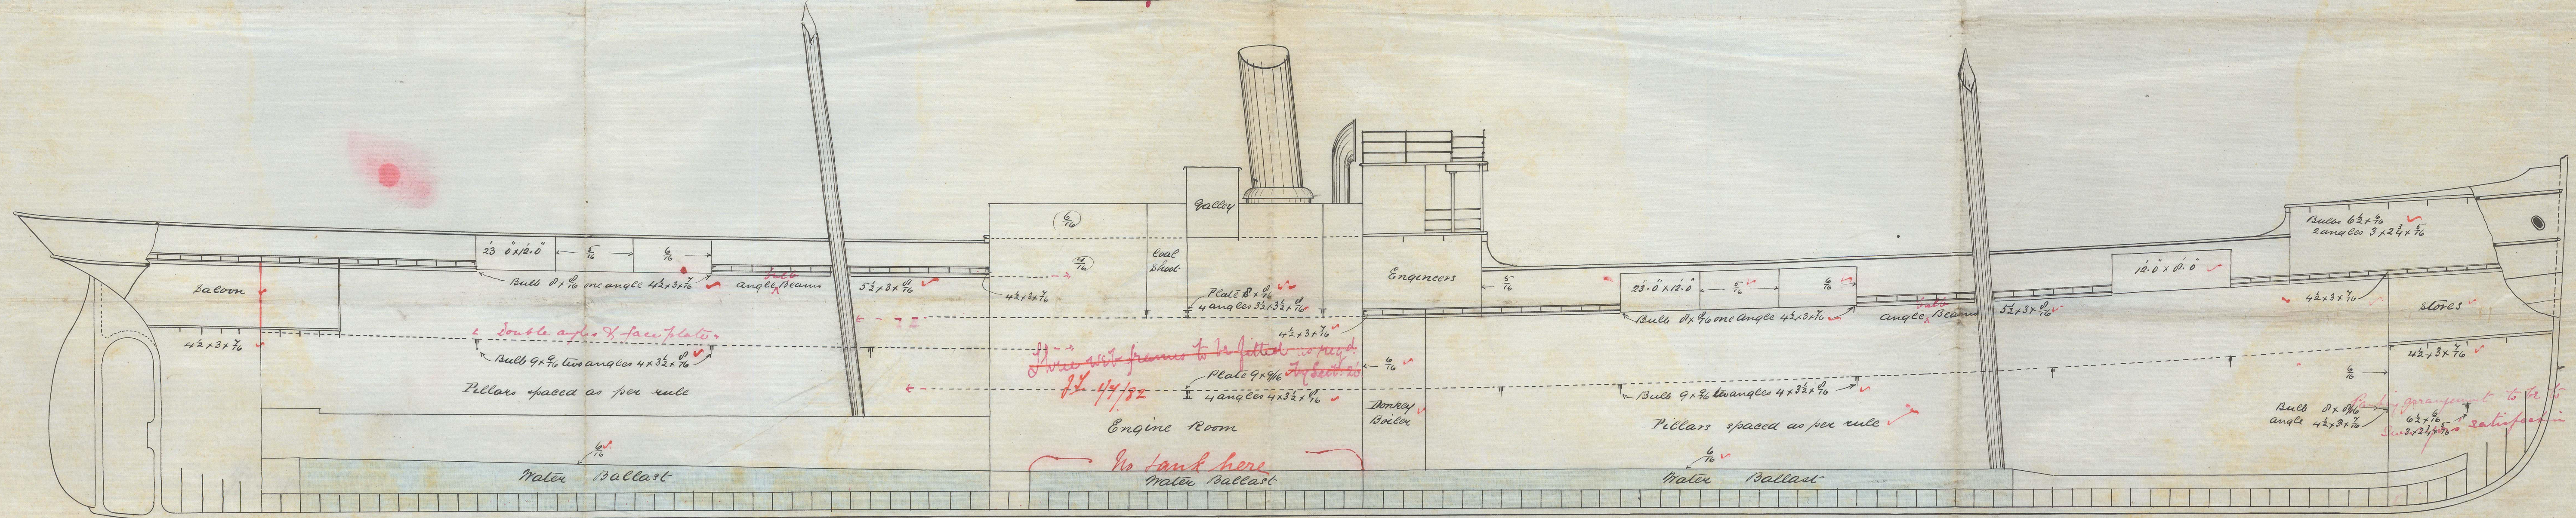

R. CRAGGS & SONS.  
Iron Shipbuilders and Repairers,  
CLEVELAND SLIPWAYS,  
MIDDLESBRO'

18/12/87

Lloyd's Register  
Foundation