

22.12.81

MIDSHIP SECTION

NO 30 22

SCALE $\frac{1}{2}$ " INCH = 1 FOOT

240. 0 x 34. 0 x 14. 6 ✓

Combined length of Quarter
Deck & Bridge exceeds $\frac{2}{5}$ length

R. CRAGGS & SONS.


Iron Shipbuilders and Repairers

CLEVELAND SLIPWAYS.

MIDDLESBRO',

Equipment

3	Bower Anchors	-- 64	0. 0	Collective Weight, 64 = 2 tons	✓
1	Stream "	-- 8	0 0		✓
1	Kedge "	-- 4	0 0		✓
1	" "	-- 2	0 0		✓
240	fathoms	1 1/2	stud-chain cable	✓	
75	"	1'	stream chain	✓	
90	"	10"	low line	✓	
90	"	8"	hawser	✓	
90	"	6"	max	✓	

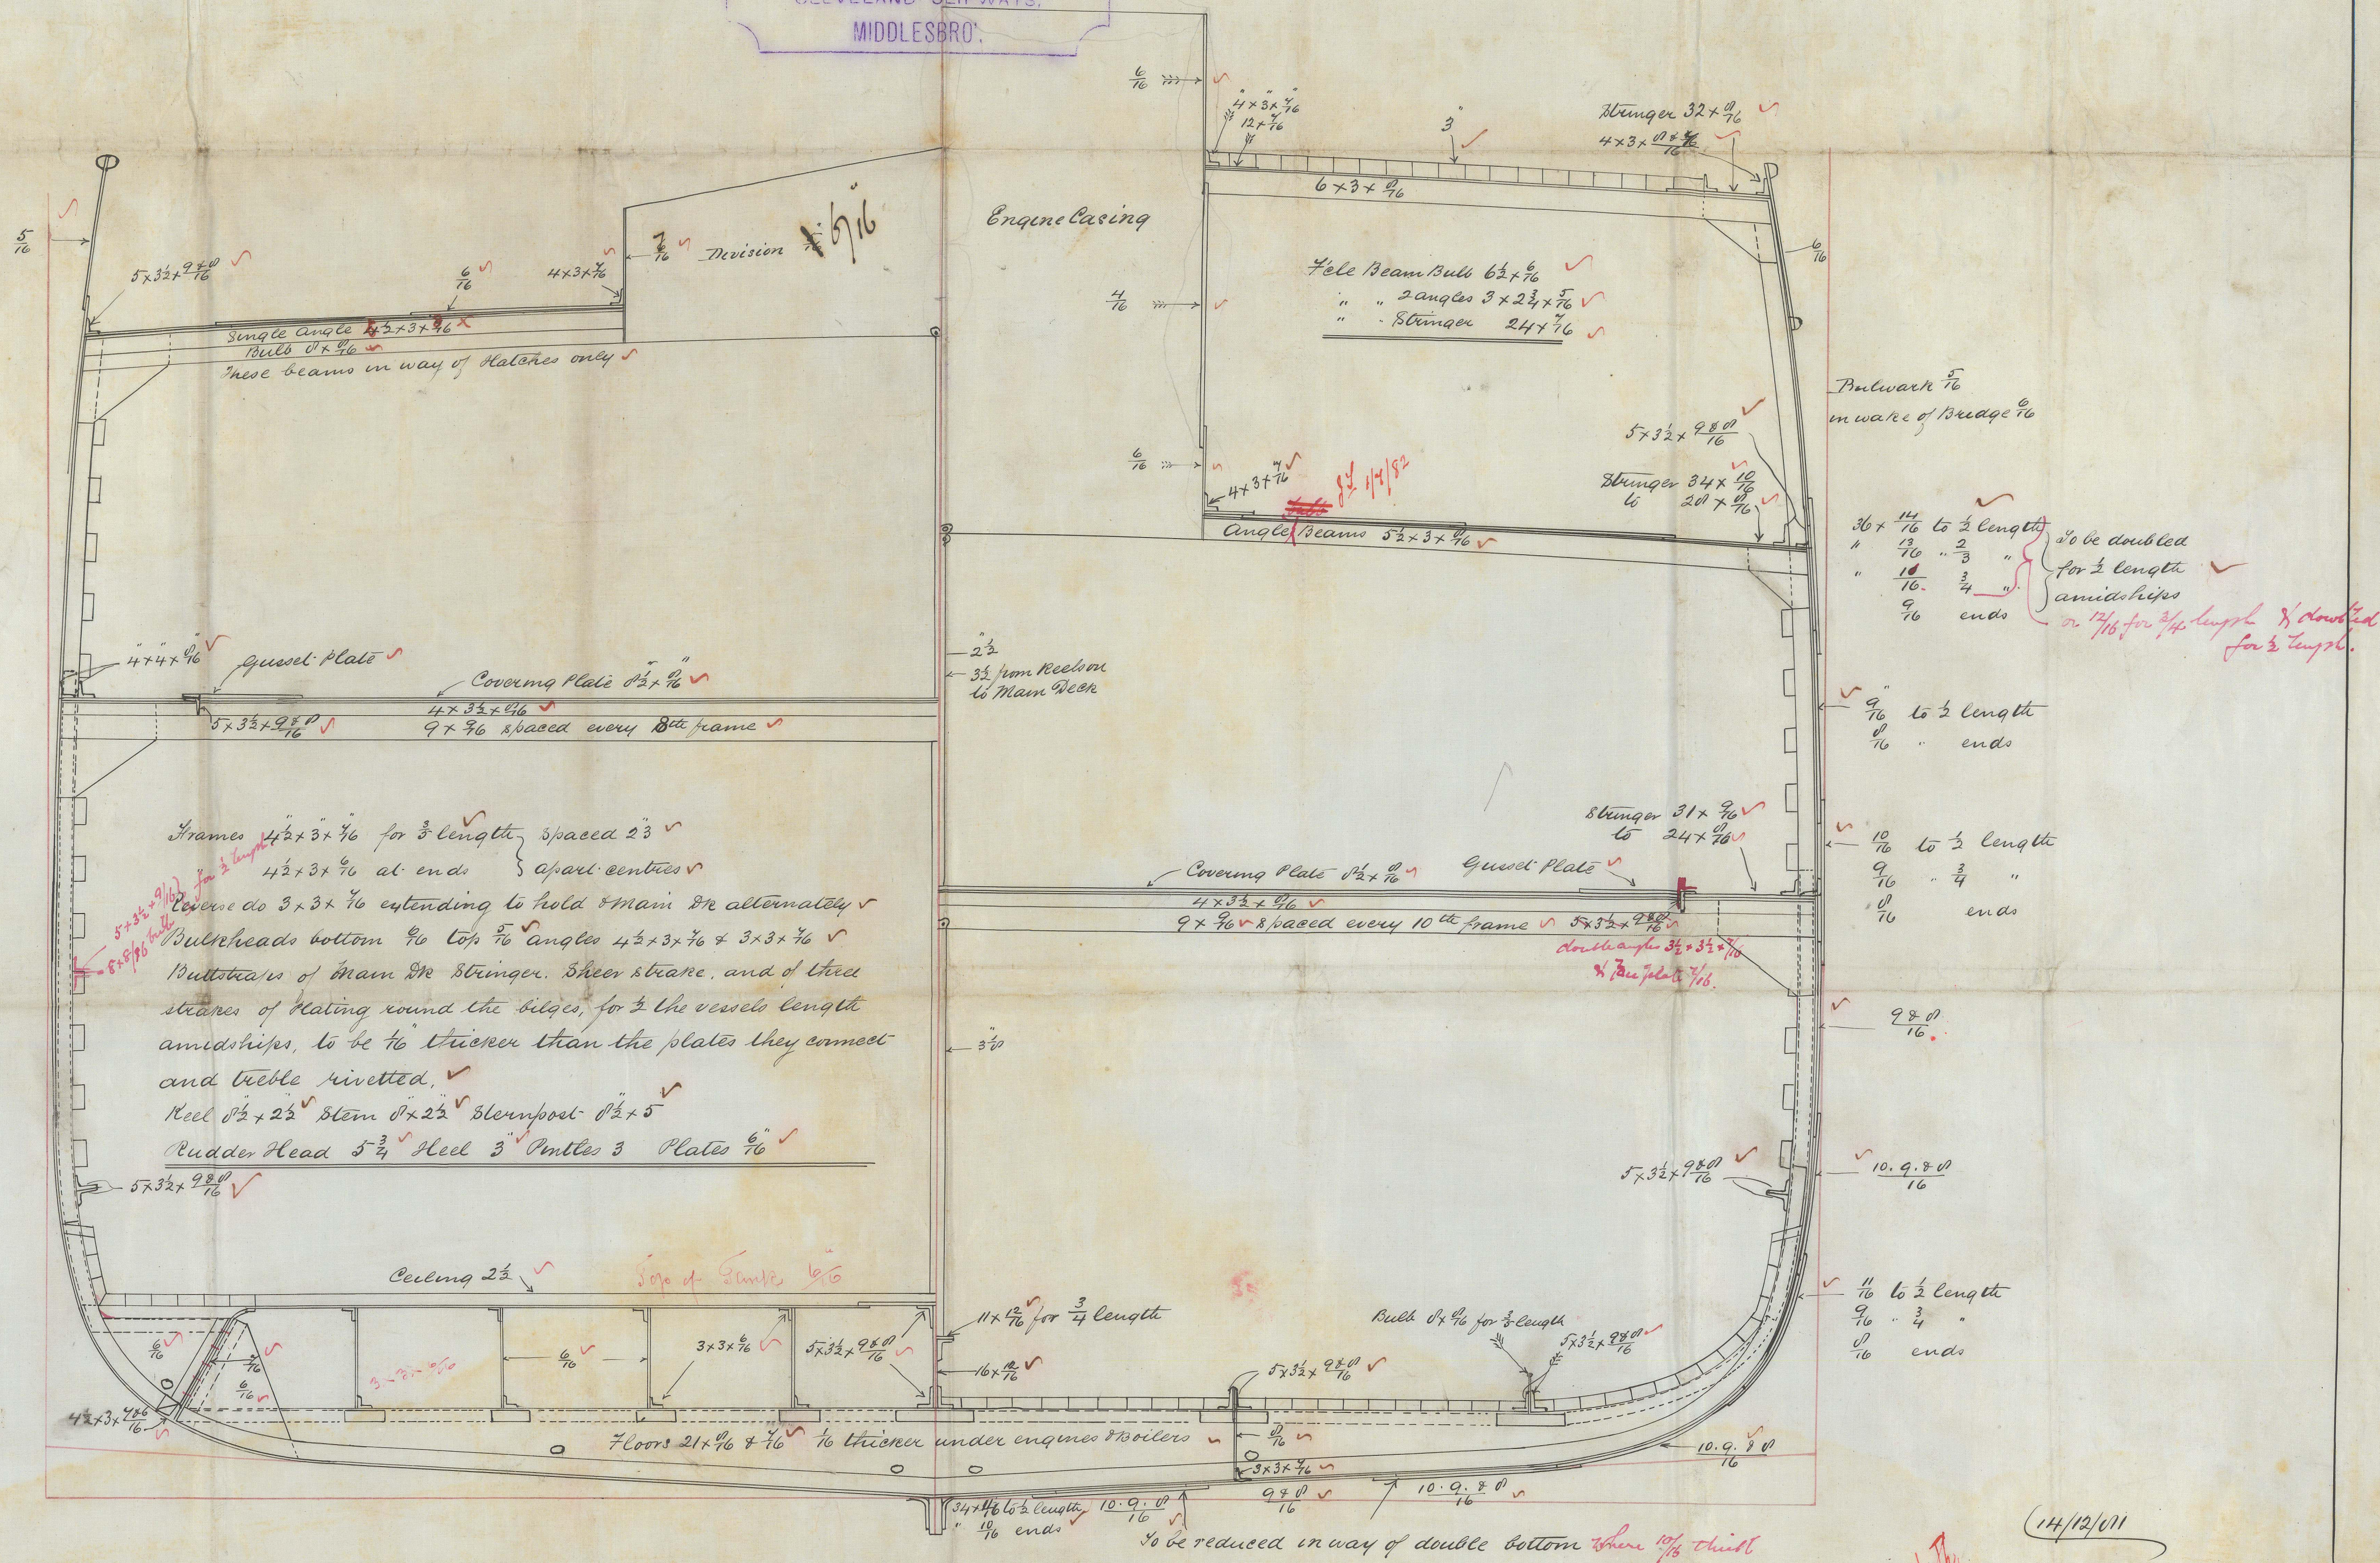

(14/12/01)

22/12/81

16th / 12 / 87 ~~1987~~

© 2021
Lloyd's Register
Foundation