


RECEIVED 2nd JY

GRAY & CO.
IRON SHIPBUILDERS
AND
REPAIRERS,
WEST HARTLEPOOL

H.S. "Maude," W. Rpt. Report No 5169.

No 270 9s. Mended plan
Scale $\frac{1}{8}'' = 1$ Foot.

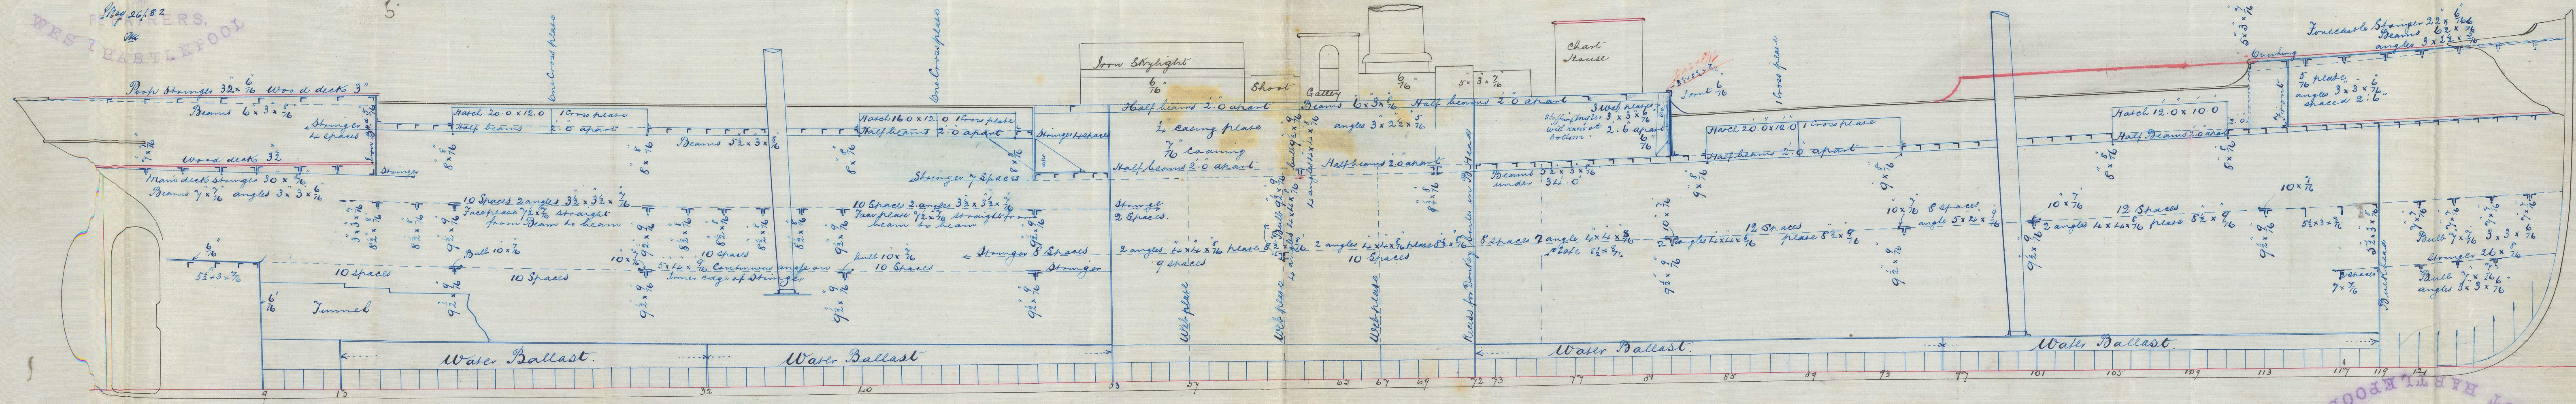

576/82

W. Rpt. 1/6/82
ms

WEST HARTLEPOOL
IRON SHIPBUILDERS
AND
REPAIRERS,
Lloyd's Register
Foundation