

S. S. Southgate ; W. Sph. Report No 5201.

Lloyd's Register of British and Foreign Shipping.

(Received in the London Office, RECORDED 11th MAY, 83.

P.

No. 148

REPORT ON SHIP FORGINGS.

Sir,

I beg leave to report that the undermentioned Forgings, manufactured by
Messrs The Stockton Forge Co of Stockton
for the Vessel No. 88, being built by *Messrs Turnbull & Sons*
of *Whitby* have been inspected by me in course
of being forged and smithed, and found to be, so far as can be seen, a good sound
frame, *The stem frame and stem for this*
Vessel was delivered in October/82.

Mark on Forging.

Lloyd's

No. 148

4/83

H. C.

I am, Sir,

Your Obedient Servant,


H. Cameron.

The Secretary,
London.

Sunderland.

	STERN FRAMES.	RUDDER FRAMES.	STEMS.
Material* - - - -	/	<i>Scrap Iron</i>	/
How made - - - -		<i>Forged</i>	
Dimensions - - - -		<i>6 1/4" - 8 1/4"</i>	
Progress on Inspection -		<i>Forging & Smithing</i>	
Dates when Inspected -		<i>March 2. 15. 29 April 13. 14. 21. 24.</i>	

SKETCHES OF FRAMES SHEWING POSITION AND DESCRIPTION OF WELDS.

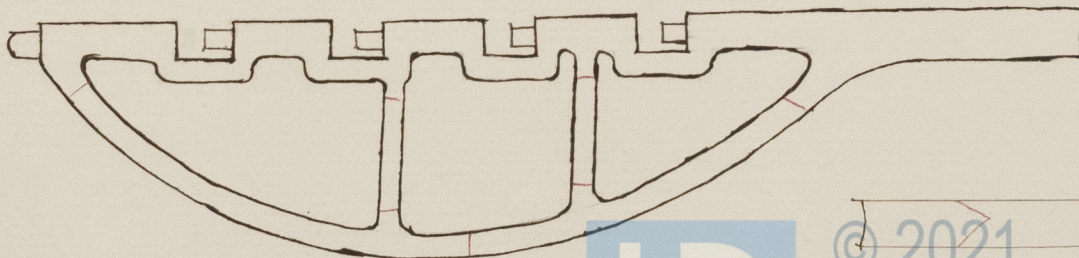

© 2021

Welds in red

Lloyd's Register
Foundation