

St. Marlboro, N. H. Report No. 5312



176 sh
26/1/88

DRAWING No 71394

D.S.
25/1/83



14' 0" mean diameter

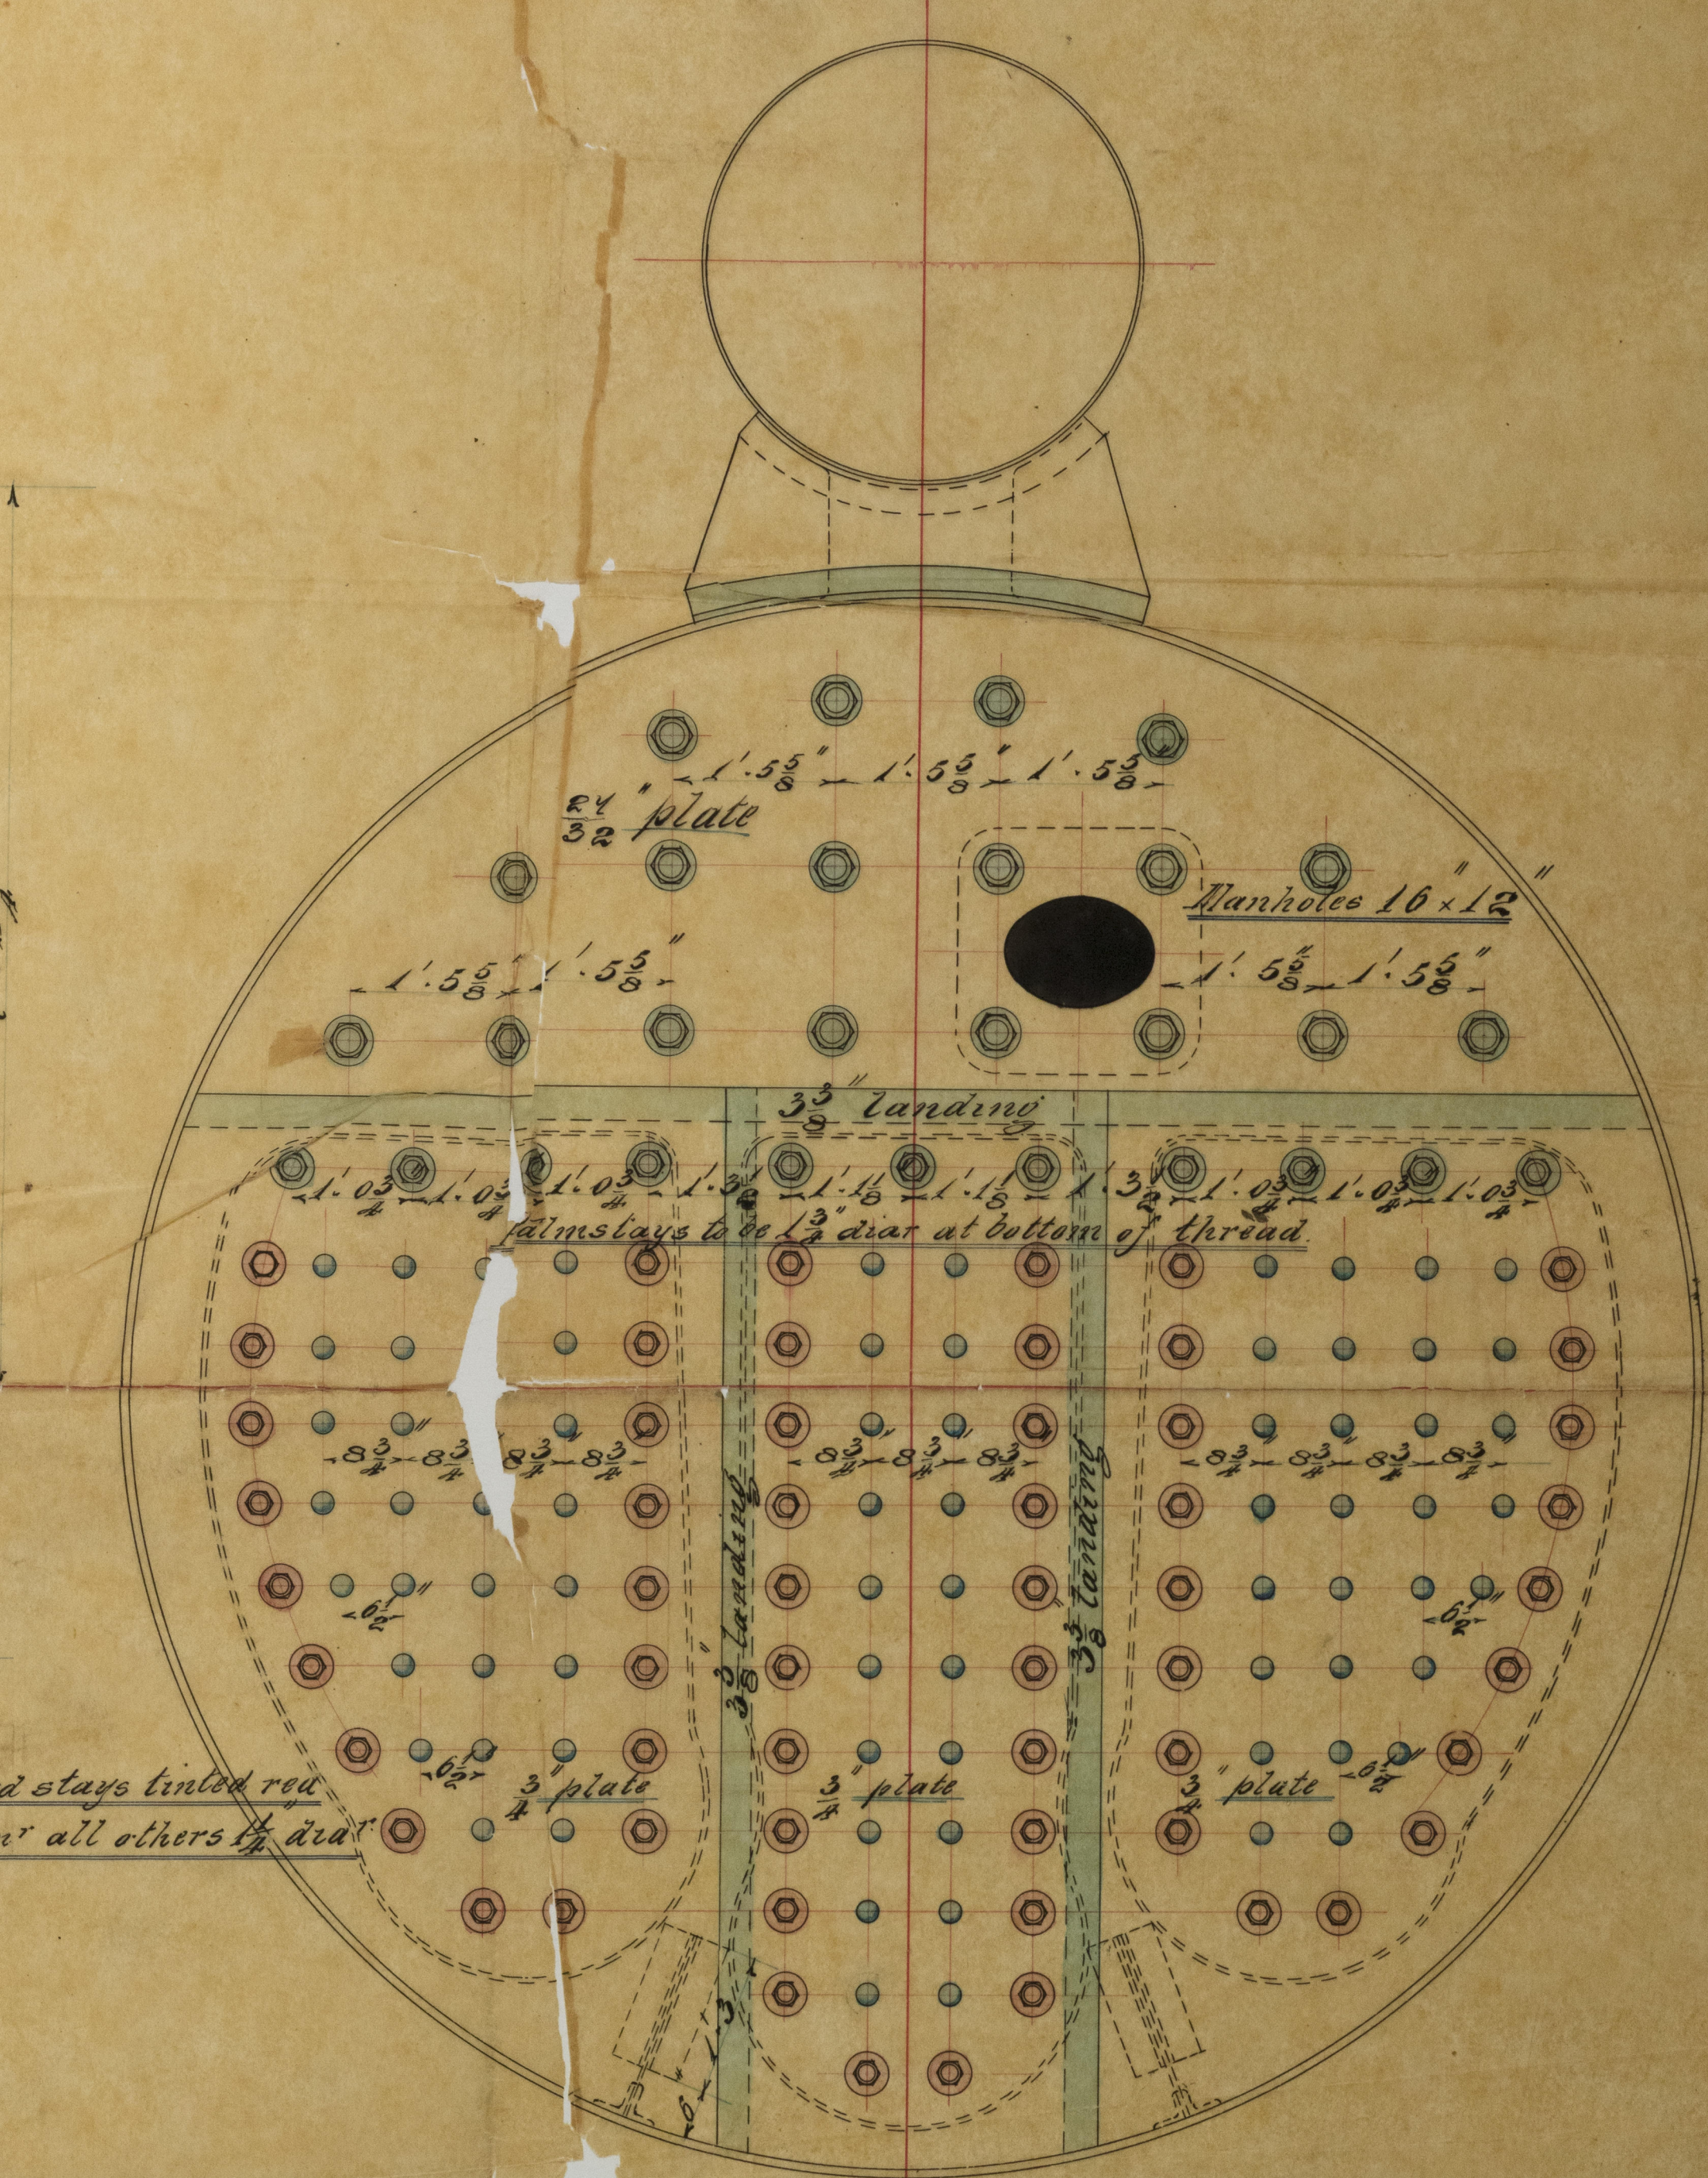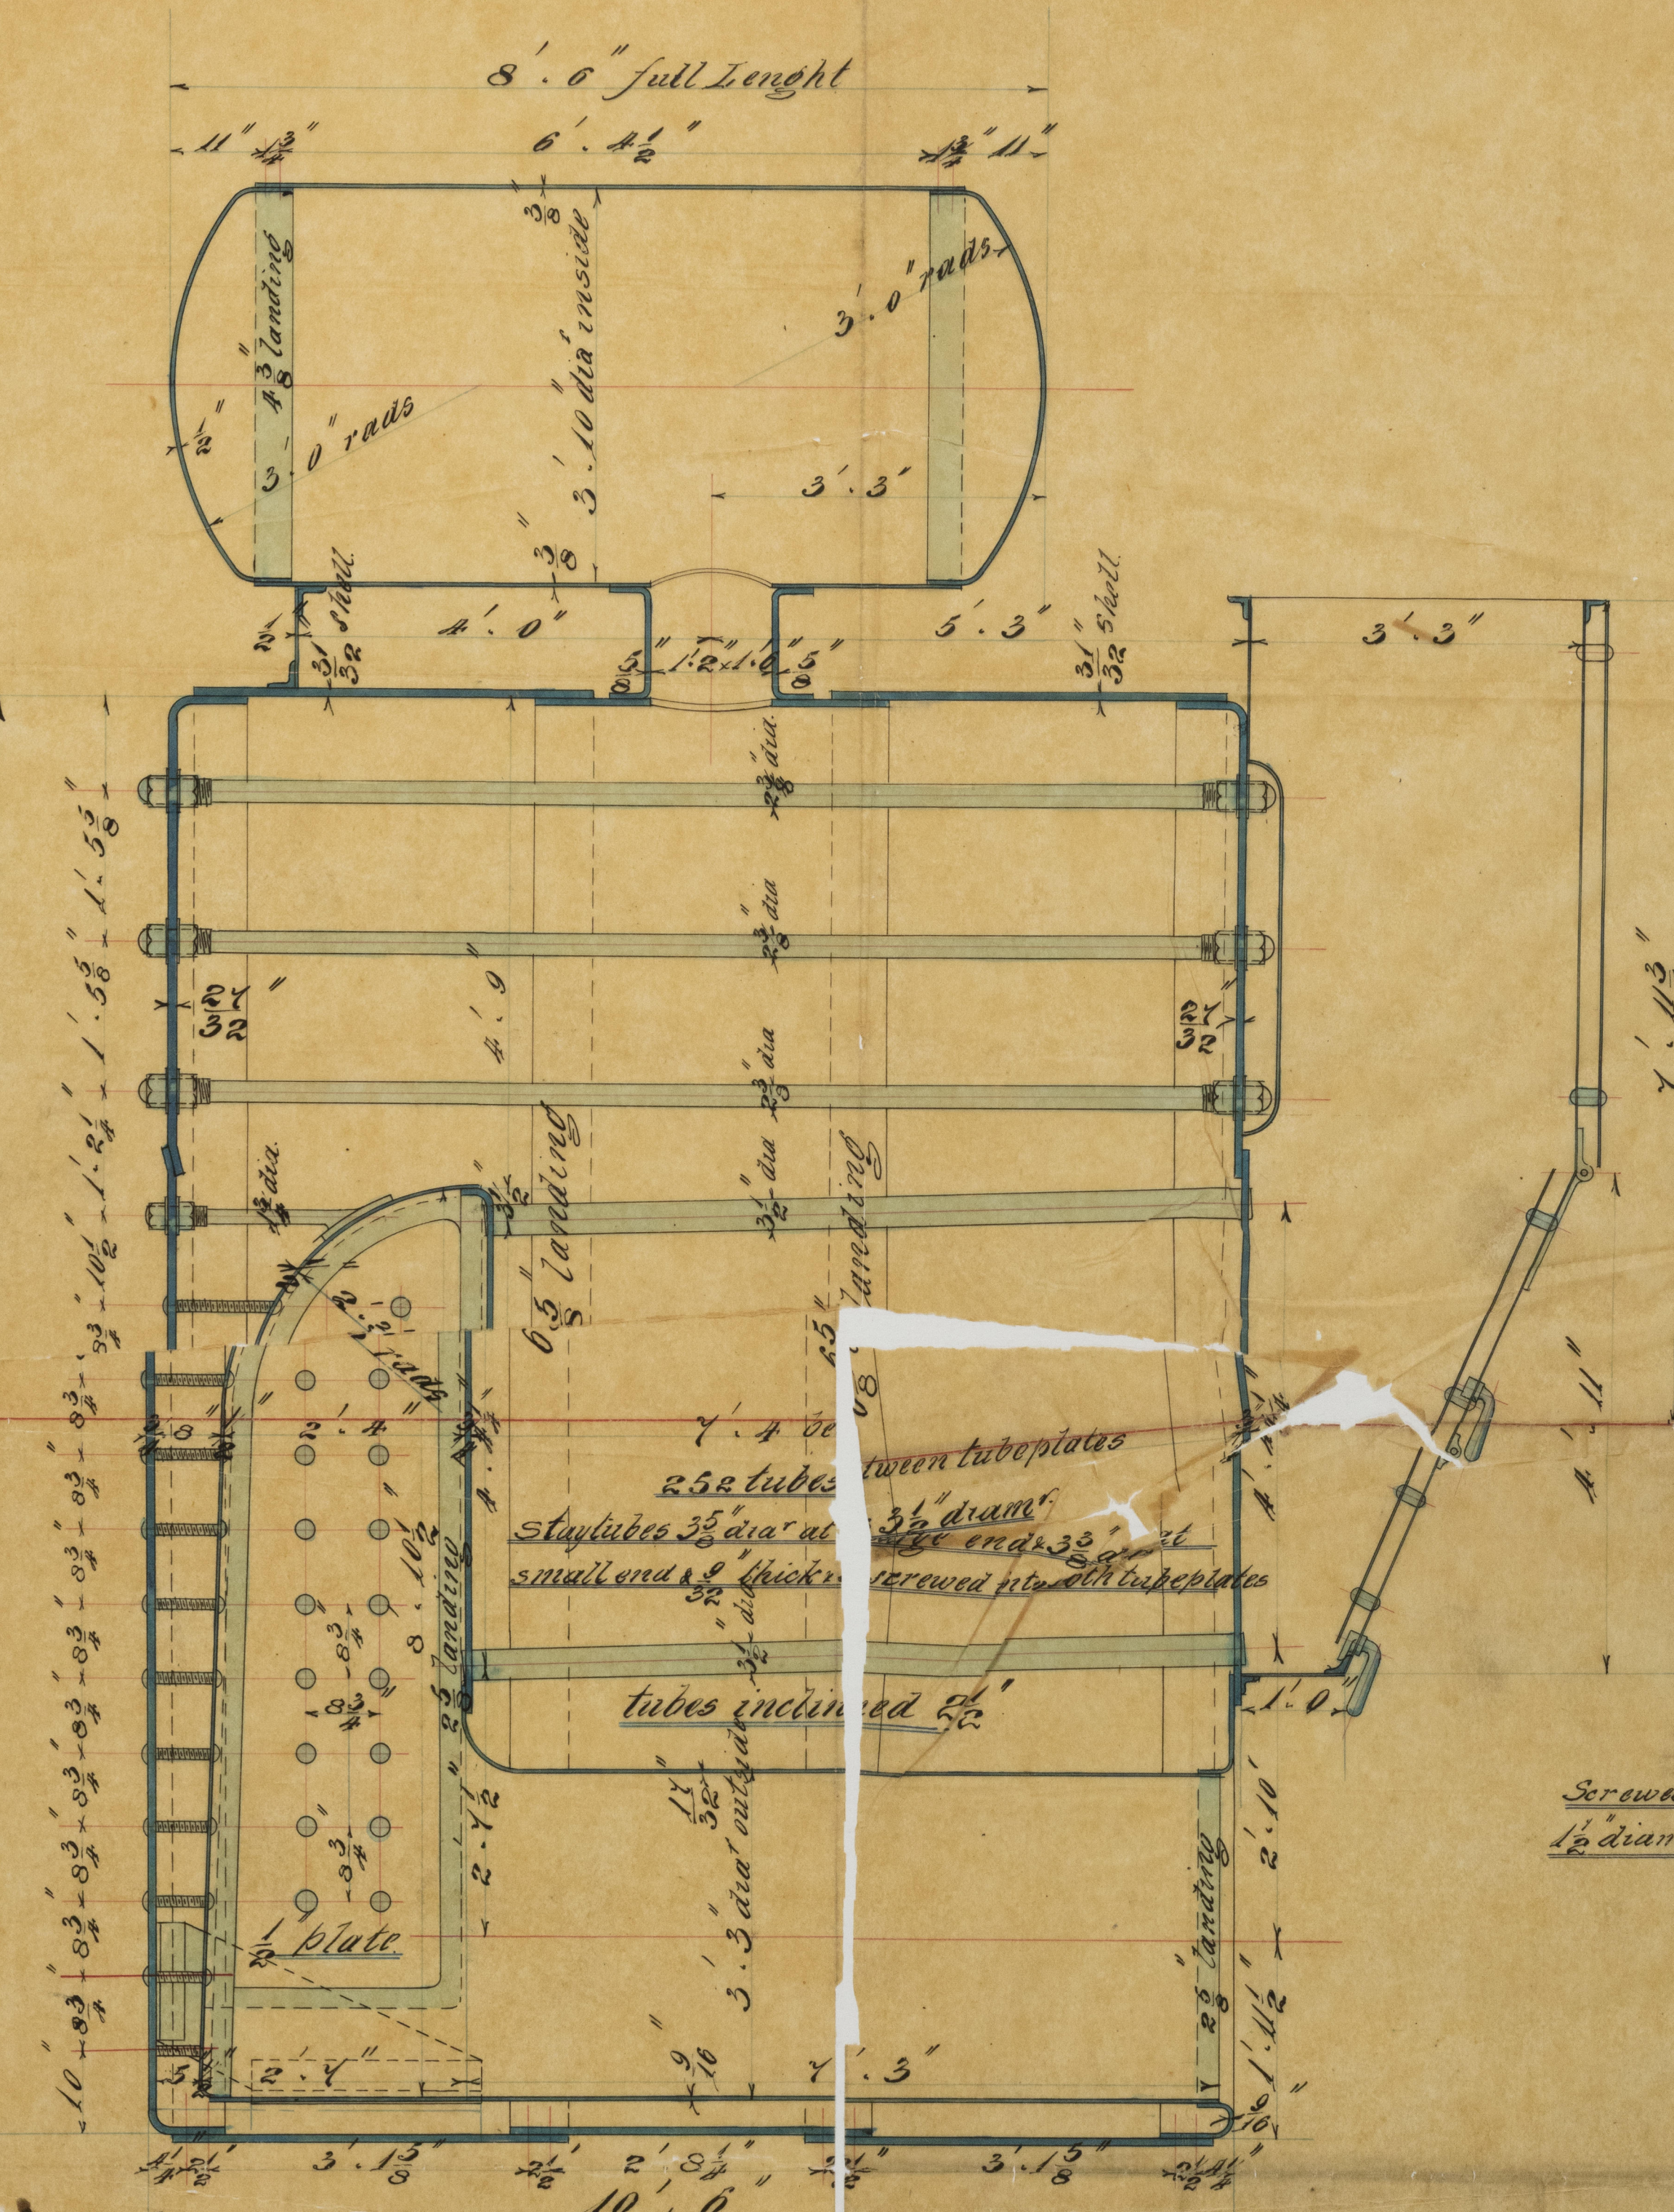

ACK. HAWTHORNE & CO
19.1.83
CITY HEAD-ON-TYPE

Boiler

Messrs W Gray & Co^{ys} ££ No 274

B. H. Co^{ys} Eng^{rs} No 685

L. Brooker
29th July 1883

Working Pressure 80 lbs pr sq inch.

- Boiler { Shell plate 3/4" thick
Horizontal seams triple riveted 1 1/2" rivets 5 1/2" pitch, drilled holes.
Circumferential seams double rivetted 1 1/2" rivets 3 1/2" pitch, punched holes.
Front & Back single rivetted 1 1/2" rivets 3" pitch.
Longitudinal seams double rivetted 1 1/2" rivets 3 1/2" pitch, drilled holes.
Dome { Circumferential seams single rivetted 1 1/2" rivets 2 1/2" pitch punched holes.

STK 908-0273

STK908-0273

1000

Working Free

Circumferential spans double + 1

Front & Back & inside of the book

18
6
2
1
6

This image shows a blank, aged, light brown page, likely an endpaper or flyleaf of a book. The paper has a textured, slightly mottled appearance with some creases and discoloration, characteristic of old paper. The left edge of the page is bound, and the overall color is a warm, yellowish-brown.

This image shows a vertical strip of aged, textured paper, likely an endpaper or flyleaf from an old book. The paper has a mottled, brownish-tan color with visible fibers and some minor staining or foxing. The texture appears slightly rough and uneven. The strip is oriented vertically and occupies the right side of the frame.




Forward stays under red
"diamond" all others at au

100

100

601-2021