

*A.P. "Maitlands", W. H. H. Report No. 5312.*  
**Lloyd's Register of British and Foreign Shipping.**

(Received in the London Office, .)

P.

No. 130

**REPORT ON SHIP FORGINGS.**

Sir,

I beg leave to report that the undermentioned Forgings, manufactured by  
*Supr. The Stockton Forge Co. of Stockton*  
 for the Vessel No. *2 1/4*, being built by *Supr. W. Gray & Co*  
 of *Hartlepool* have been inspected by me in course  
 of being forged and smithed, and found to be, so far as can be seen, *sound*,

Mark on Forging.

**Lloyd's**

No. 130  
 3/83 *H.C.* 7/83

I am, Sir,

Your Obedient Servant,


*H. Cameron,*

The Secretary,  
 London.

*Sunderland,*

	STERN FRAMES.	RUDDER FRAMES.	STEMS.
Material* - - - -	<i>Scrap Iron</i>	<i>Puddled &amp; Scrap Iron mixed</i>	<i>Scrap Iron</i>
How made - - - -	<i>Forged</i>	<i>Forged</i>	<i>Forged</i>
Dimensions - - - -	<i>7 1/4 x 4 3/4"</i>	<i>5 1/4 x 3"</i>	<i>7 1/4 x 2 3/8"</i>
Progress on Inspection -	<i>Forging &amp; smithing</i>	<i>Forging &amp; smithing</i>	<i>Forging</i>
Dates when Inspected -	<i>Jan 8-20-25 Feb 13-15-21 March 2-6<sup>th</sup></i>	<i>June 15-18-21-29 July 3-11-14<sup>th</sup></i>	<i>March 2-6<sup>th</sup></i>

SKETCHES OF FRAMES SHEWING POSITION AND DESCRIPTION OF WELDS.

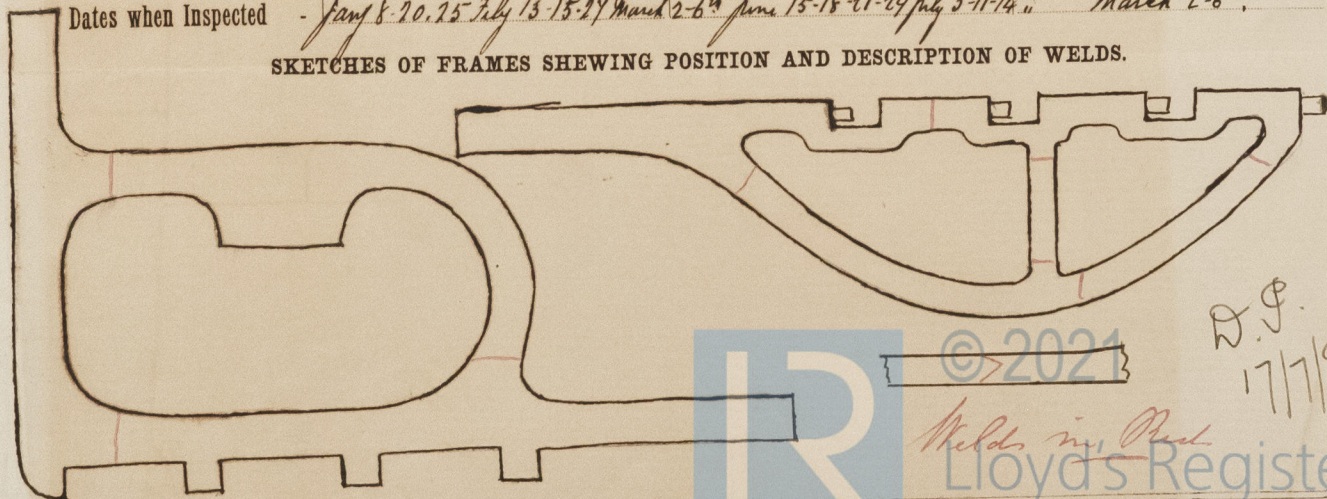

\* If of iron, state whether scrap or puddled iron.