


A. S. Zurich, W. Spc. Report No. 5395.

# Lloyd's Register of British and Foreign Shipping.

(Received in the London Office,

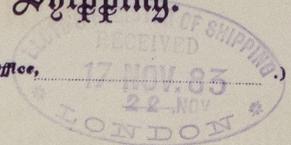

F.

No. 364

## REPORT ON SHIP FORGINGS.

Sir,

I beg leave to report that the undermentioned Forgings, manufactured by Messrs The Stockton Forge Co of Stockton for the Vessel No. 93, being built by Messrs J. Humbell & Sons of Whitby have been inspected by me in course of being forged and smithed, and found to be, so far as can be seen, sound and efficient.

M 19/11/83

Mark on Forging.

**Lloyd's**  
 No. 364  
 4/13 11/83  
 H.C.

I am, Sir,

Your Obedient Servant,


H. Cannon,

The Secretary,  
London.

Sunderland,

	STERN FRAME.	RUDDER FRAME.	STEM.
Material*	Scrap Iron	Scrap Iron	Scrap Iron
How made	Forged	Forged	Forged
Dimensions	9' x 4 7/16"	5 3/4" x 3"	8' x 2 1/2"
Progress on Inspection	Smithing	Forging & smithing	Finished
Dates when Inspected	June 15-18-21 July 3-5-11 <sup>th</sup>	Sept 14-15-19 Oct 2-5-11 22-27 Nov 2, 10-15 <sup>th</sup>	July 3 <sup>rd</sup>

SKETCHES OF FRAMES SHEWING POSITION AND DESCRIPTION OF WELDS.

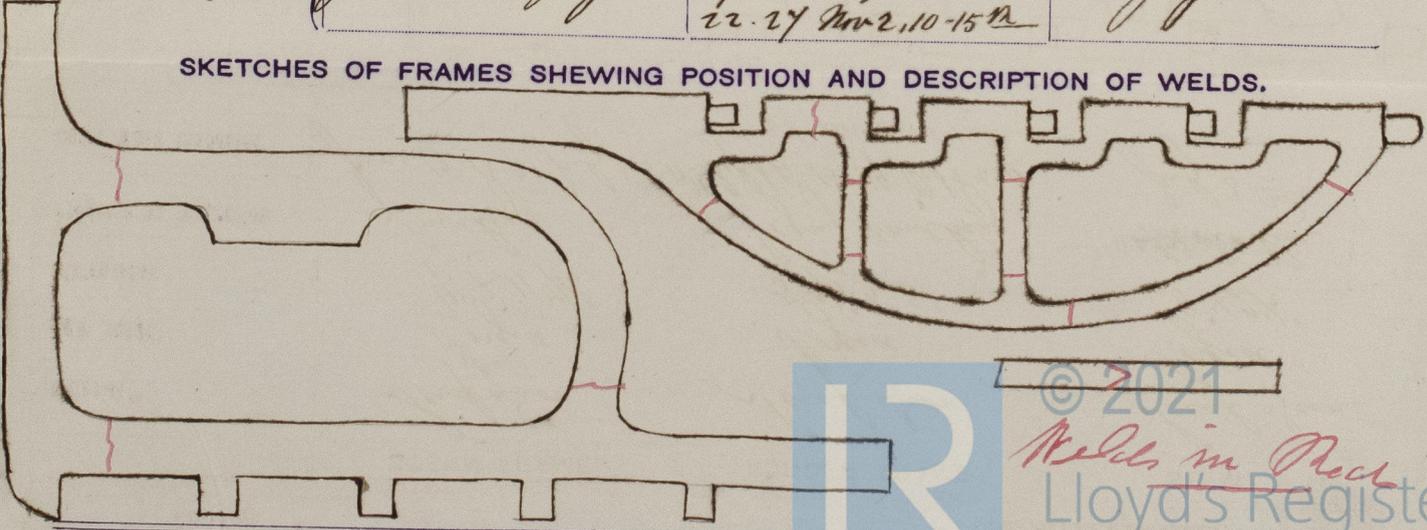

\* If of iron, state whether scrap or puddled iron.

