

Л.Л. № 93:


LONGITUDINAL SECTION

SCALE $\frac{1}{8}" = \text{ONE FOOT}$

Bridge deck. 3" thick
Hanger plate $2\frac{1}{2} \times \frac{1}{16}$ Tee plate $9 \times \frac{1}{16}$
Beams $6\frac{1}{2} \times 3 \times \frac{1}{16}$ angle iron.
Sidelapting $\frac{1}{16}$.



Forecastle
Wood deck 3" thick
Beams Bull 6 1/2 x 9 1/6 angles 3 x 3 1/4 x 9 1/6
Springer plate 2 1/2 x 9 1/6 Lef plate 9 x 11 1/6
Self lifting 9 1/6

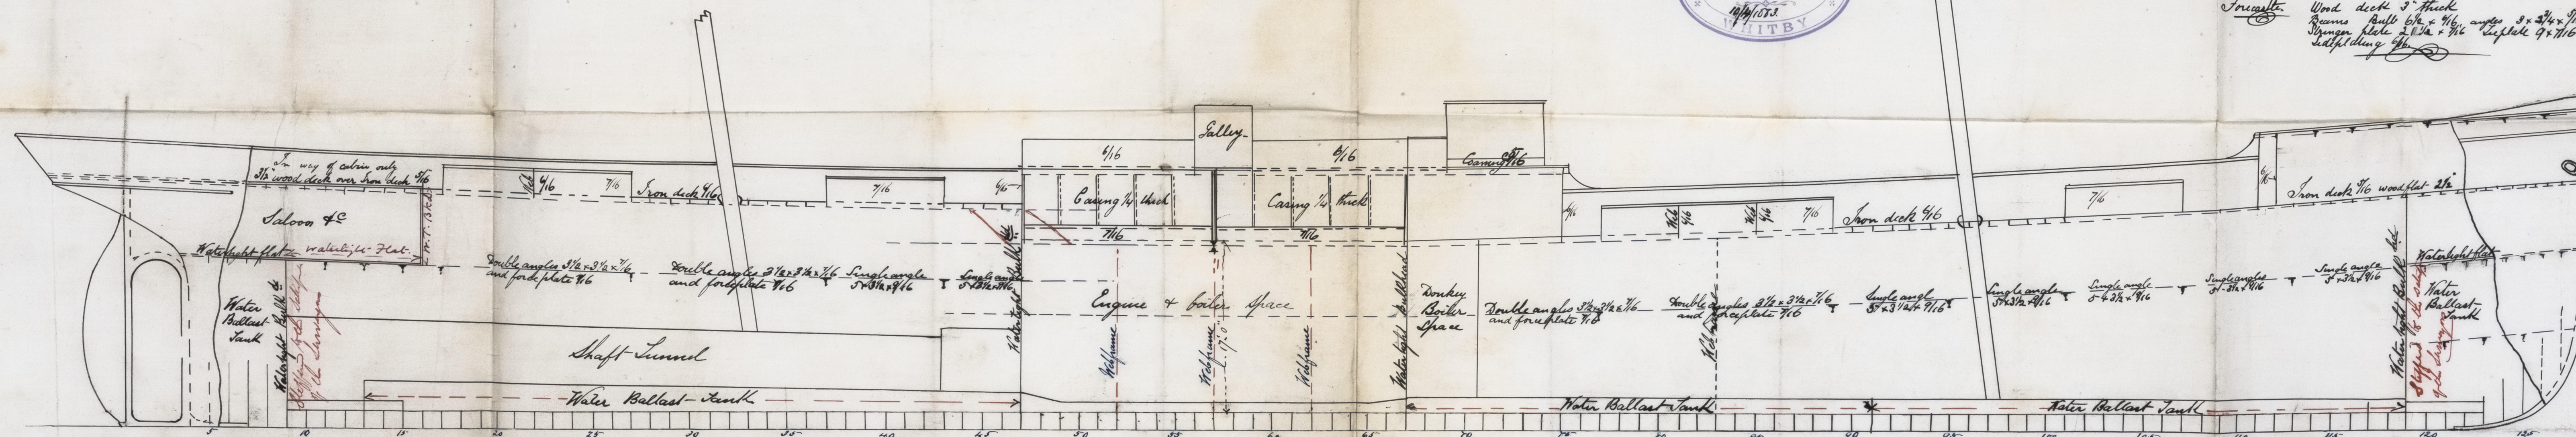

10/4/83