


A. D. Zurich, W. H. H. Report No. 5395

Dr: W. H. H.
19/4/83.

S. S. N^o 93;
MIDSHIP SECTION;

SCALE 1/2" = ONE FOOT.

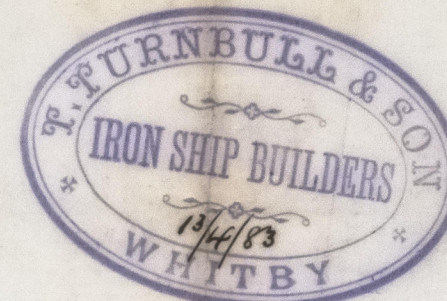

Lloyd's Numerals.

Length as per Rule 243.75
Breadth moulded 33.83
Depth from keel to top of beam 16.74
Depth from keel to top of floor 17.00


Half breadth 16.91
Depth to keel 16.74
Half girth 32.00

Transverse 67.62 x 243.75 = 16482 Plating No.
18130 Equivalents No.

Principal dimensions

Length on upper deck 245.0
Breadth extreme 32.0
moulded 33.10
Depth moulded 18.82
of hold to top of floor 17.0

Class 100A Lloyd's.

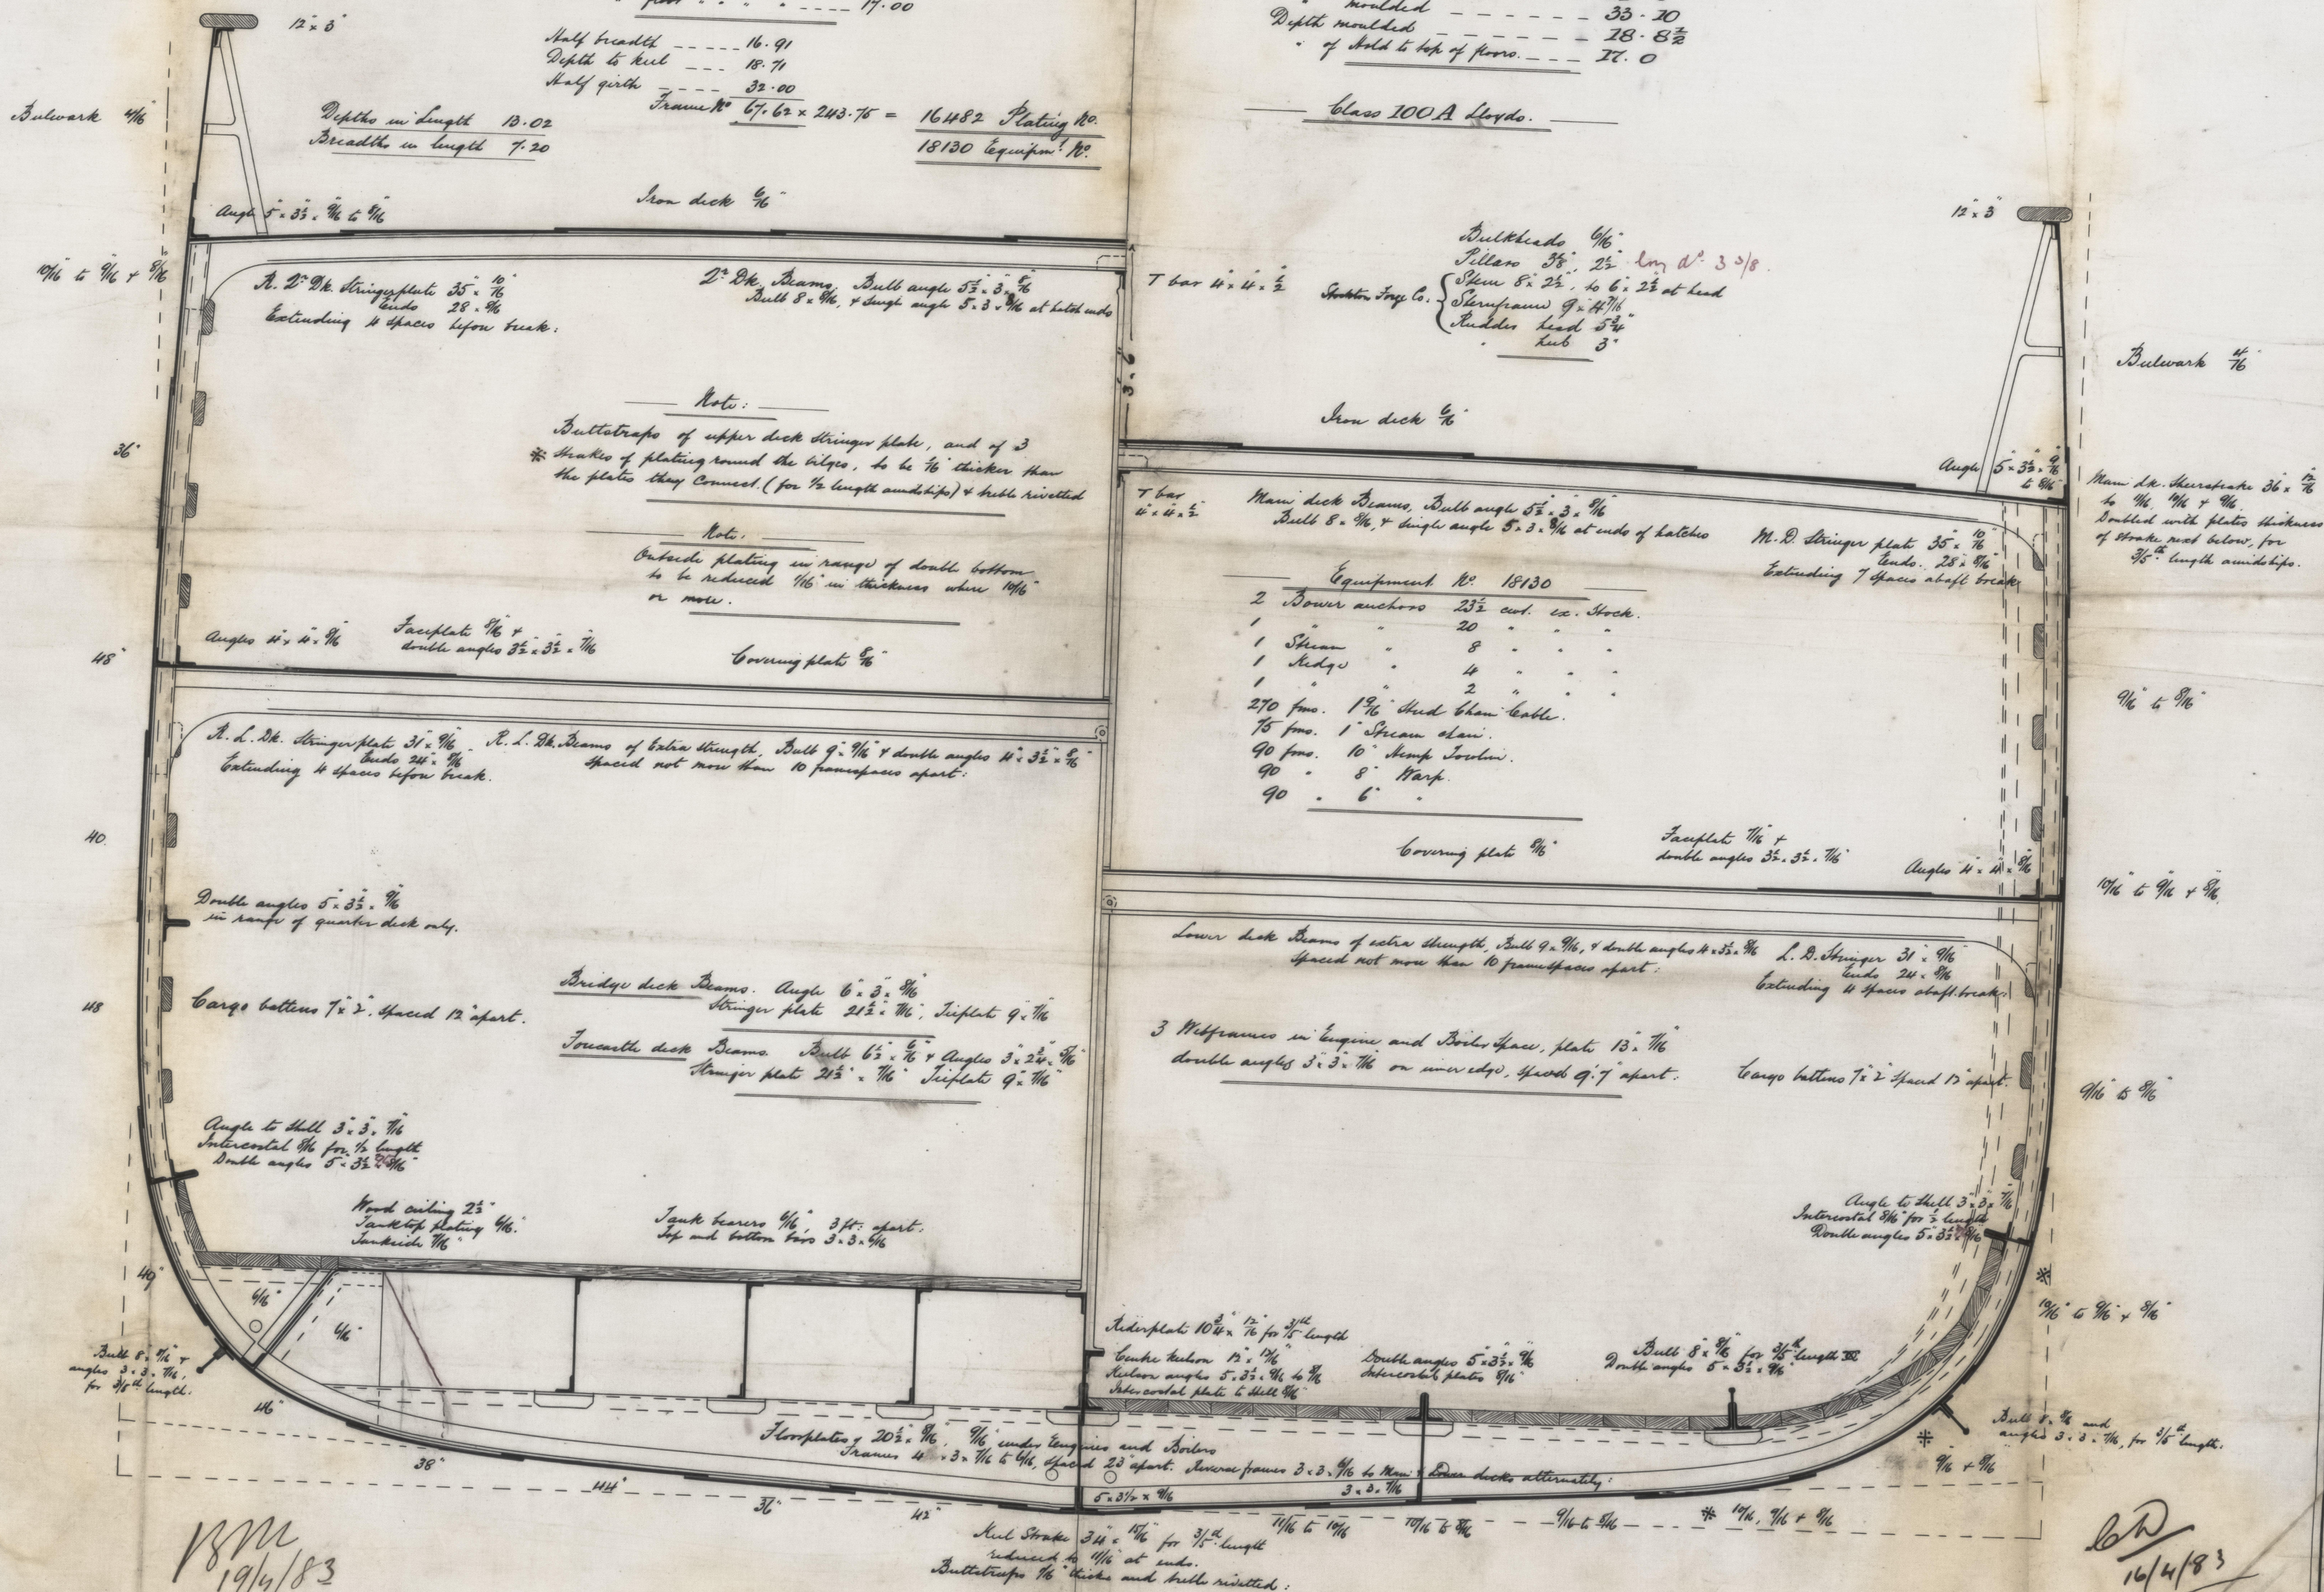

18M
19/4/83

16/4/83