


LLOYD'S REGISTER
5/11/83
27/6/83

S.S. "Mercurio", W. Hpt. Report N^o 5496.

N^o 287 S.S.

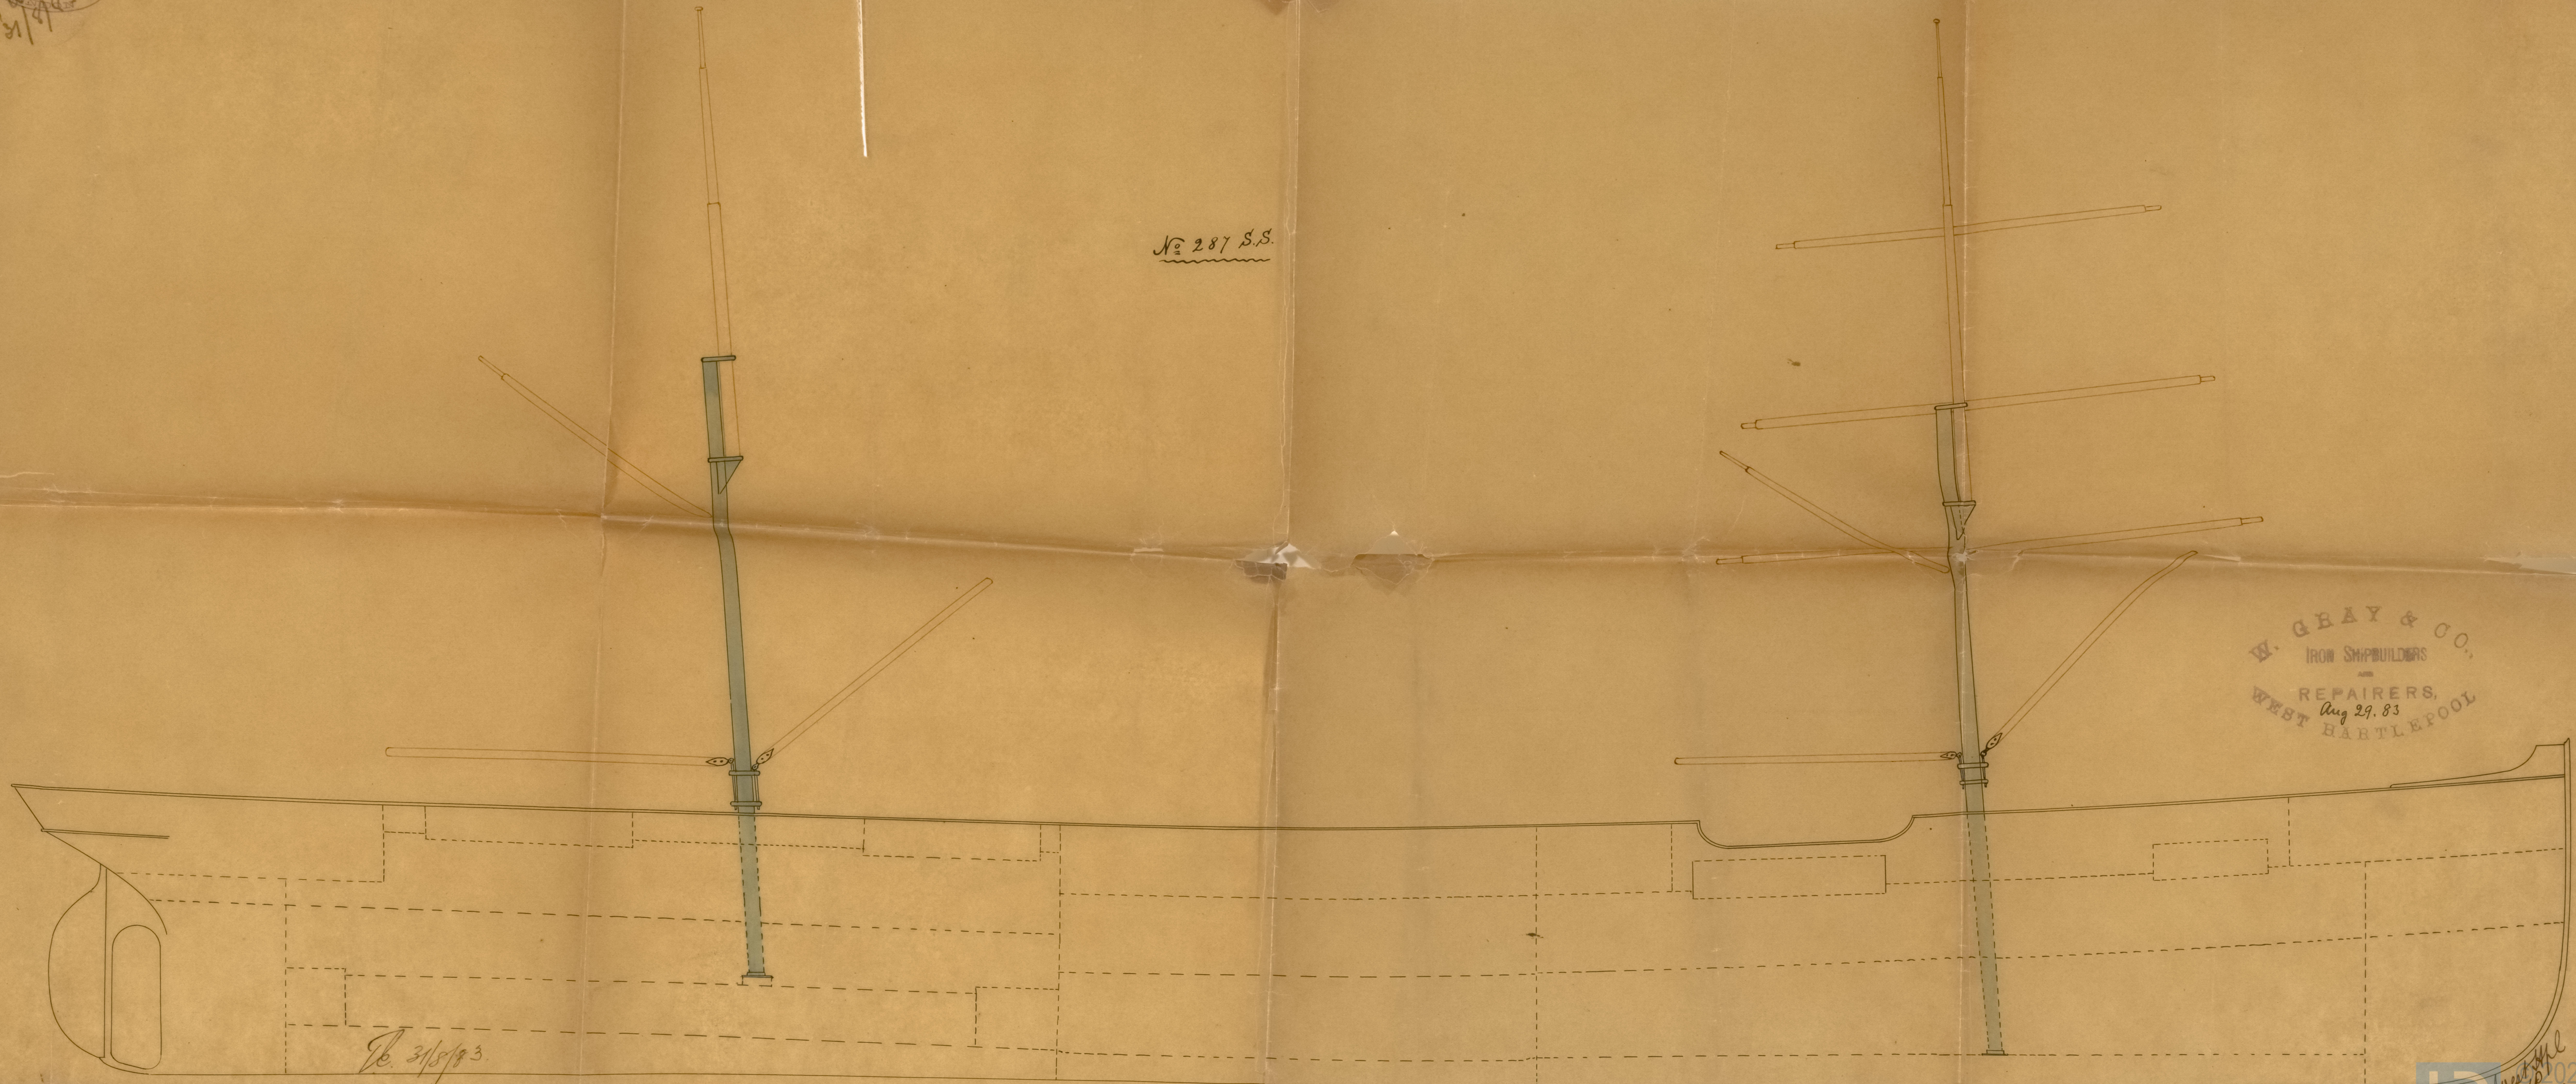

W. GRAY & CO.,
IRON SHIPBUILDERS
AND
REPAIRERS,
Aug 29. 83
WEST BARTLEPOOL

Pl. 3/8/83.