


Dr. H. W. Hpl.
28/7/83.

S.S. "Mercurio," H. W. Hpl. Report N. 5476.

Amended
PROFILE
SCALE $\frac{1}{8}'' = 1 \text{ FOOT.}$

Structure at
(displacement)
2700 tons

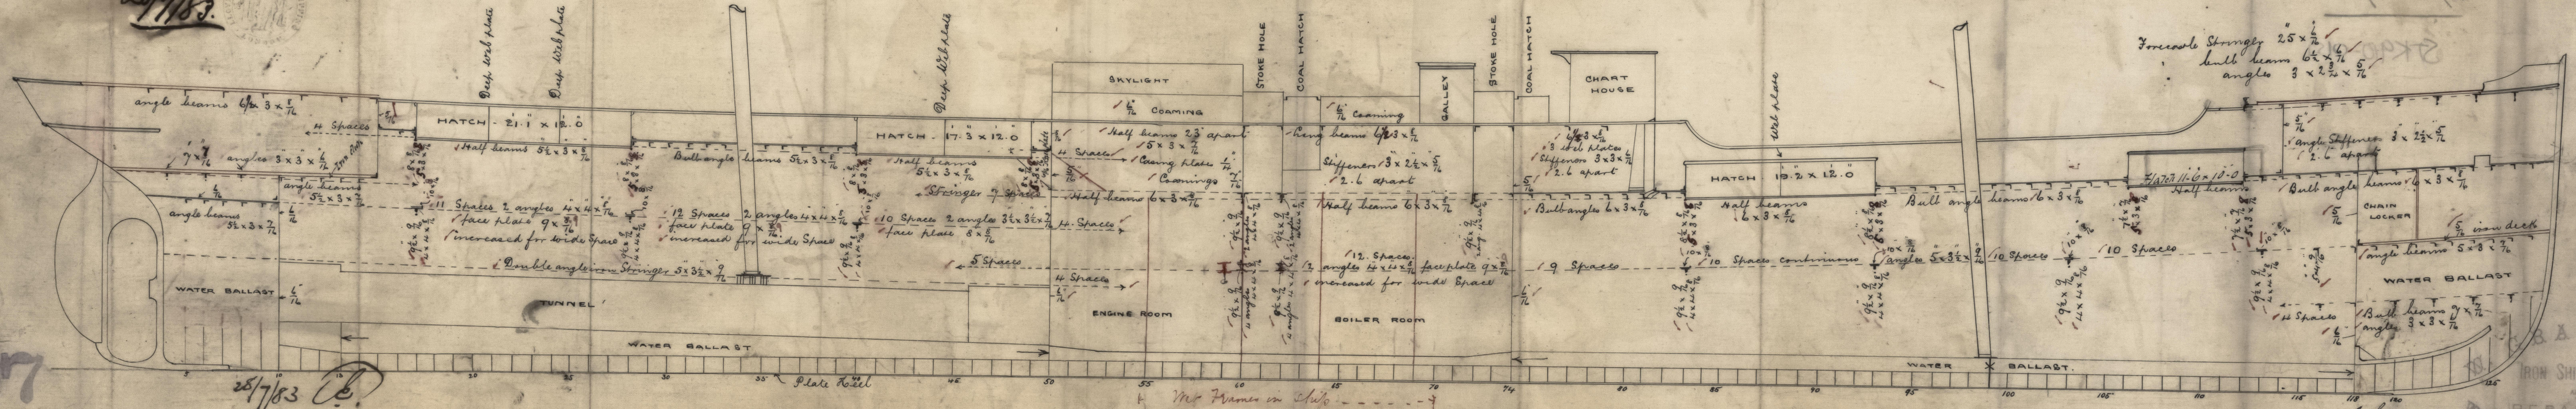

287

28/7/83 C.E.

Mr. Frames in ship

J.L. 26.4.83

STRAND-0151

IRON SHIPBUILDERS
AND
REPAIRERS
WEST

to Arthur
(everyingilio)

Hpl. 5476

STK910-015

$\frac{1}{2} \times \frac{1}{2} \times \frac{1}{2}$


CHAIN
LOCKER

angle beam 2 x 8 x 10

WATER BALLAST


© 2021

Lloyd's Register
Foundation