


Midships Section of No. 91 S. S. 795 + 97
Scale 1/2 inch = 1 foot. 100 A Grade

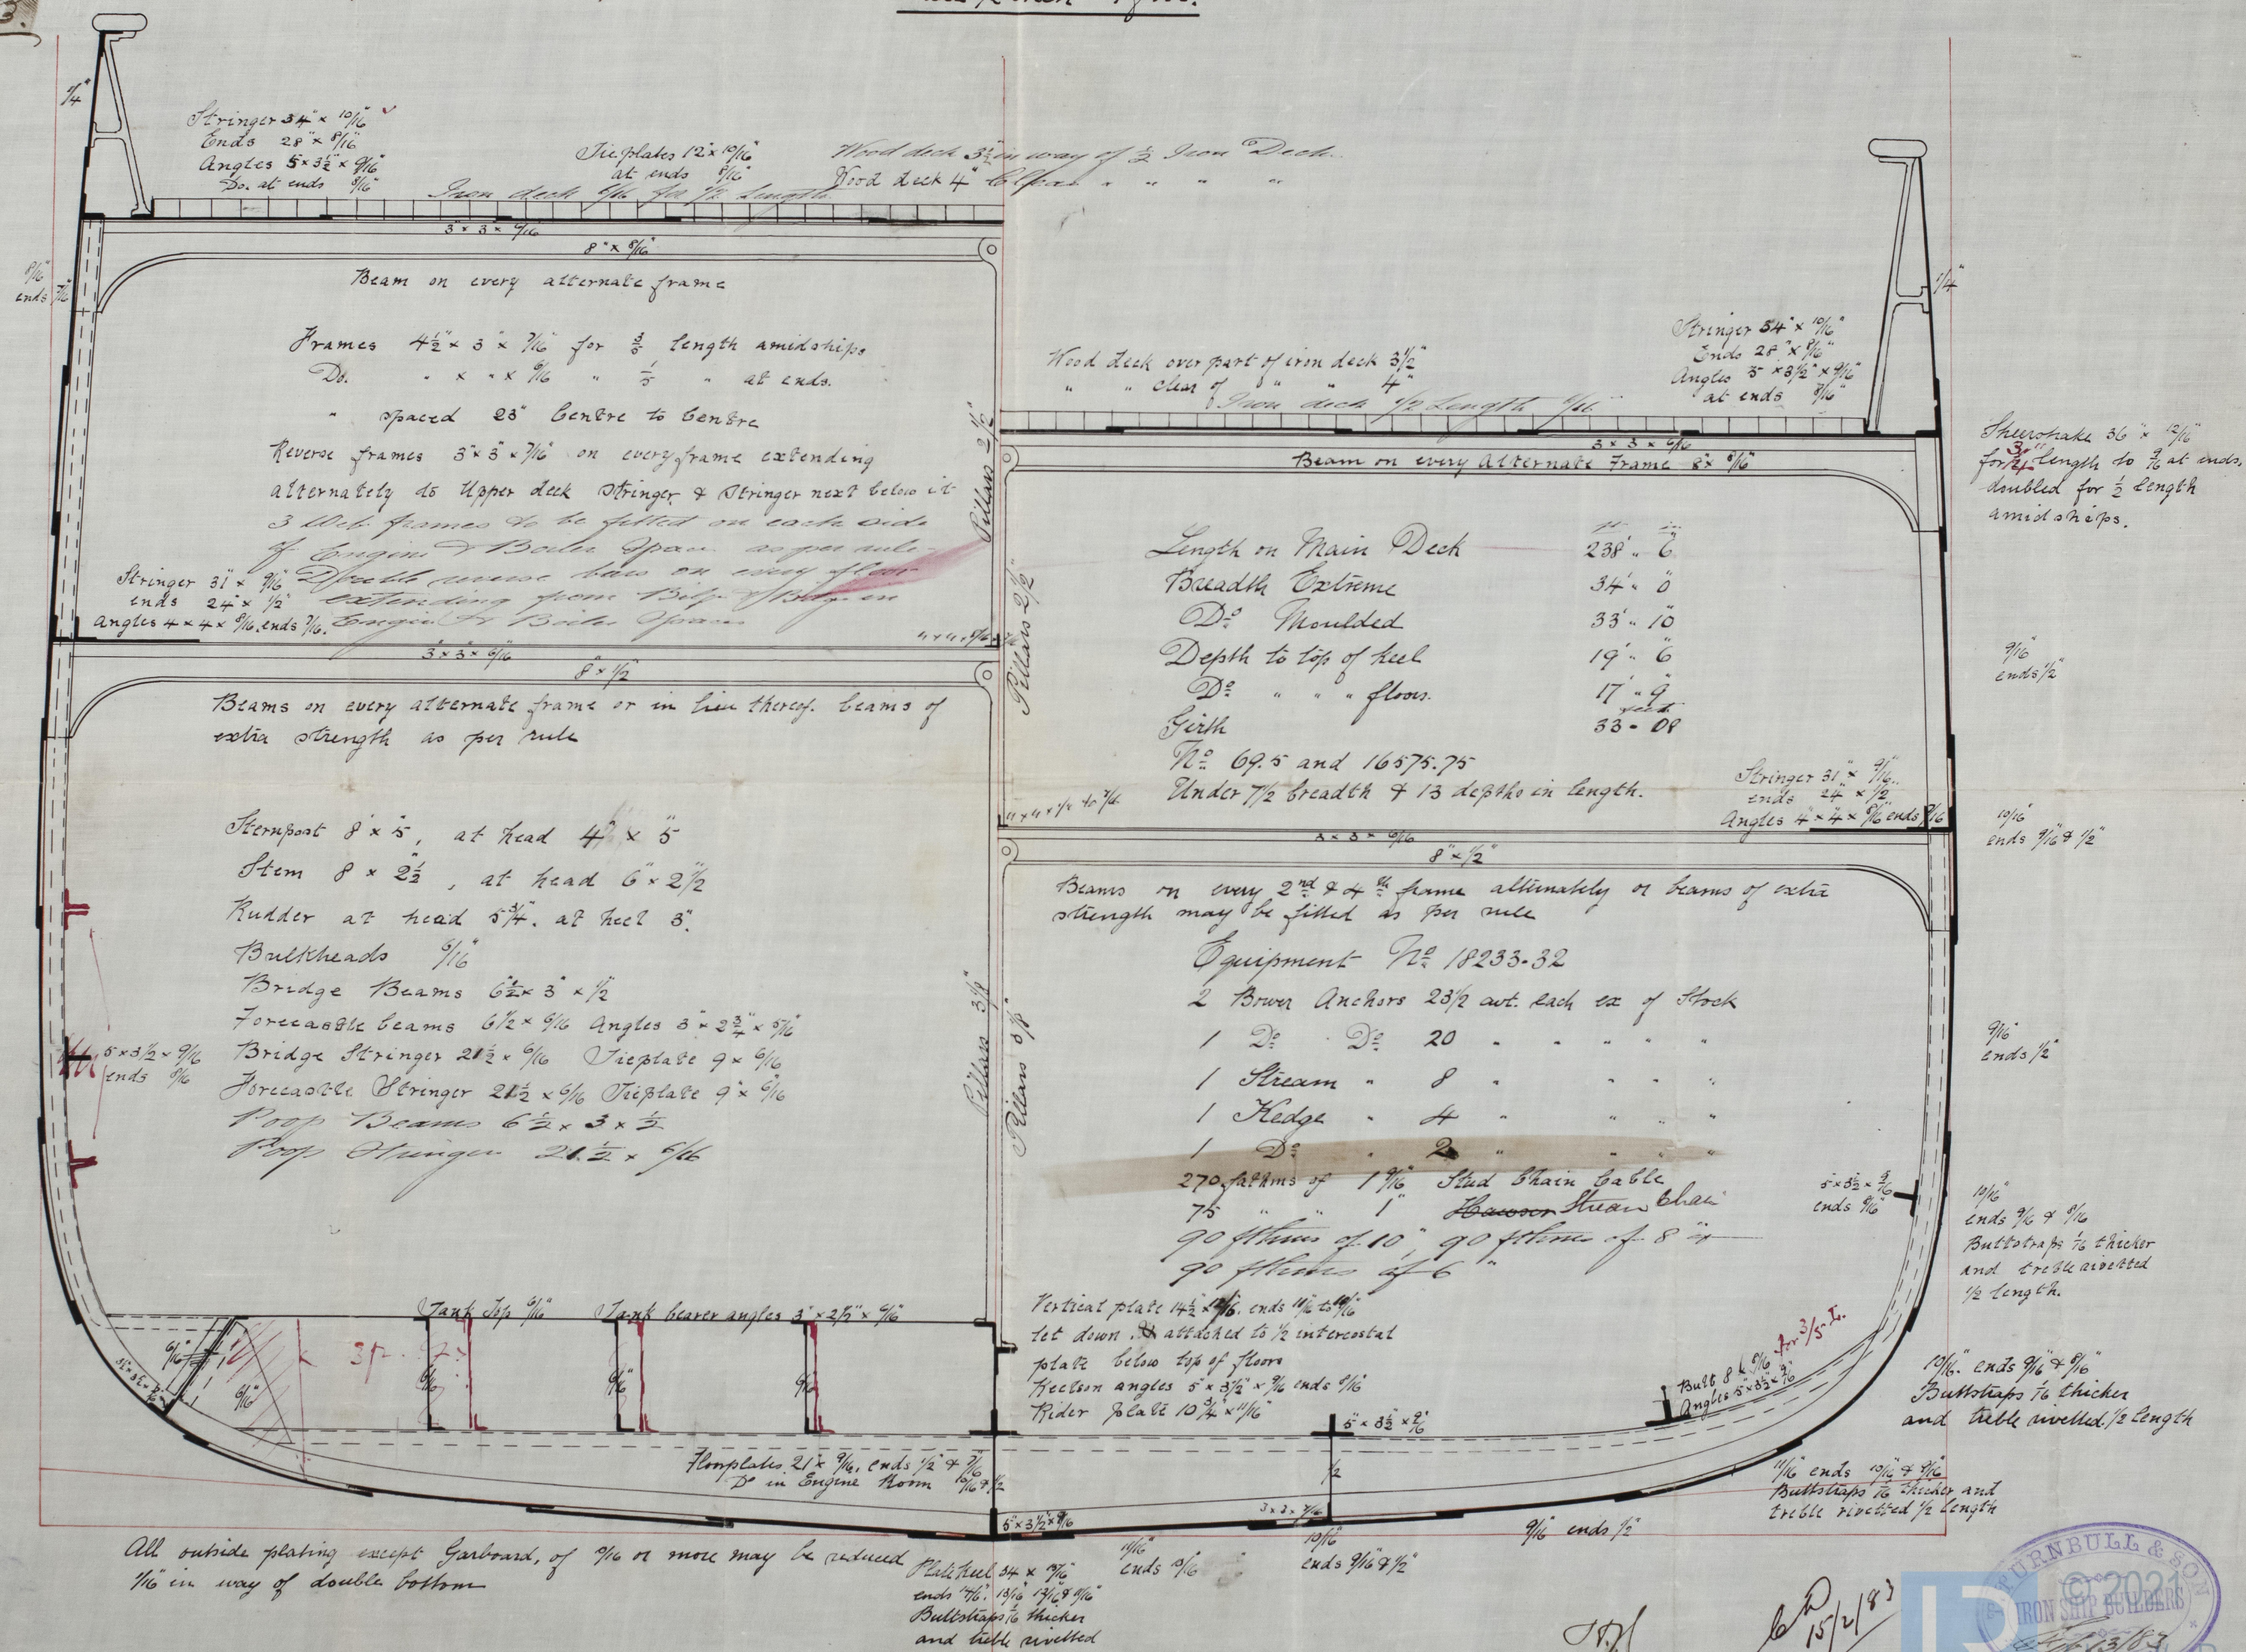

All outside plating except Garboard, of $\frac{3}{16}$ or more may be reduced $\frac{1}{16}$ in way of double bottom

19/2/8

15/2/82



Lloyd's Register
Foundation
ST#910-0328