

Lloyd's Register of British and Foreign Shipping.

*S.S. "Invermay" (Report on Vessel No. 5520 Port West Kipl)*

No. 49.A. SHIP FORGINGS OR CASTINGS.

The words FORGINGS or CASTINGS, IRON or STEEL, should be struck out as may be required.

I have to report that the undermentioned Iron or ~~Steel~~ Forgings or Castings, manufactured by Messrs R. Baynall & Son of Hylton for the Vessel No. 94, being built by Messrs Turnbull & Son of Whitley have been inspected by me as set forth below, and found to be, so far as can be seen, sound and efficient.


Mark on Forgings.

Lloyd's  
No. 49 A  
H.C

W. Cameron.  
Sunderland.

|                          | STERN FRAME.              | RUDDER FRAME.                 | STEM.           |
|--------------------------|---------------------------|-------------------------------|-----------------|
| Material* - - - -        | <u>Scrap iron</u>         | <u>Scrap iron</u>             |                 |
| How made - - - -         | <u>Forged</u>             | <u>Forged</u>                 |                 |
| Dimensions - - - -       | <u>9 x 4 7/16</u>         | <u>5 1/4 - 3"</u>             |                 |
| Progress on Inspection - | <u>Smithed</u>            | <u>forged &amp; smithed</u>   | <u>Not seen</u> |
| Dates when Inspected     | <u>Jan'y 29 July 7/84</u> | <u>March 8-20 April 18/84</u> |                 |

SKETCHES OF FRAMES SHEWING POSITION AND DESCRIPTION OF WELDS OF FORGINGS, OR PARTICULARS OF TESTS APPLIED TO CASTINGS.

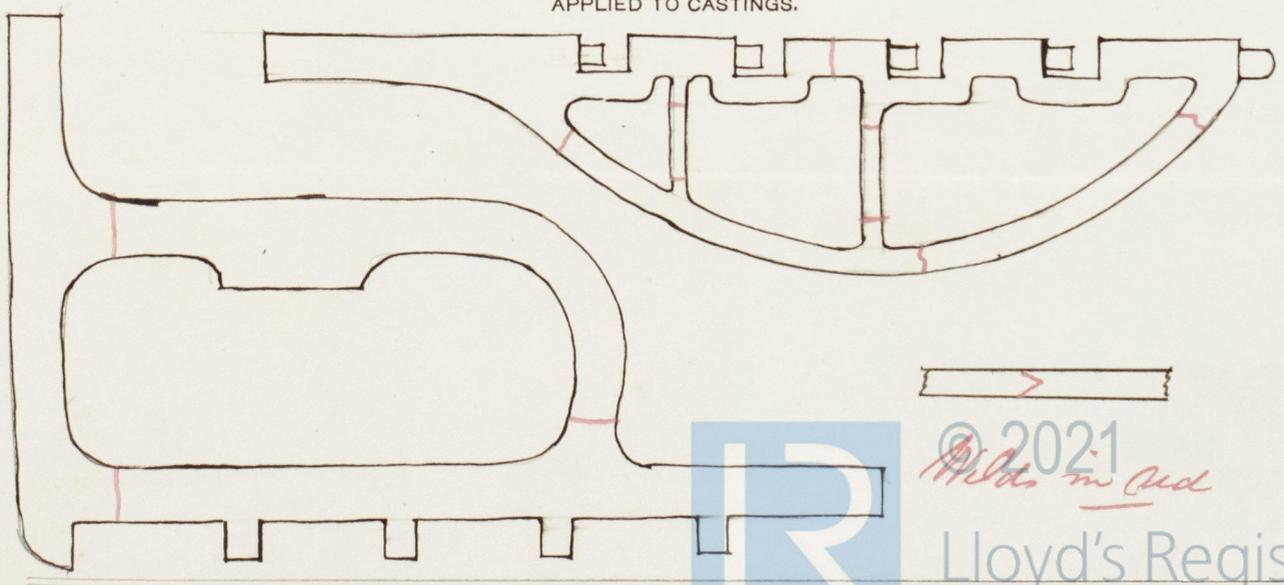

© 2021  
Welds in Red

Lloyd's Register  
Foundation

\* If of Iron, state whether scrap or puddled iron.