


W. H. Hpl.
16/8/84

Barque "Balthamie" W. Hpl. Report N: 5707


SAILING BARQUE
— N^o 299 —
— SCALE $\frac{1}{8}$ = 1 FOOT —

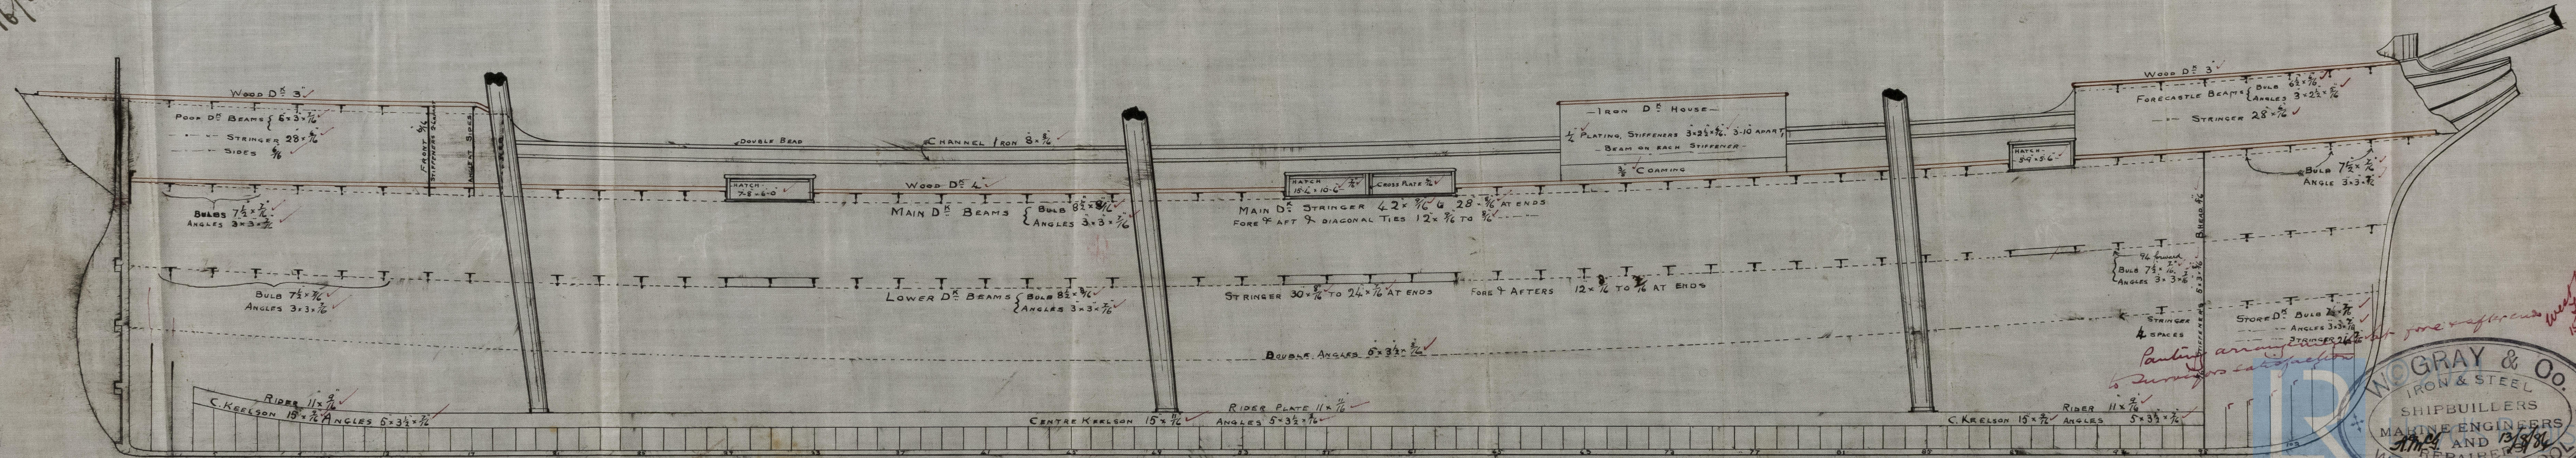

W. GRAY & CO.
IRON & STEEL
SHIPBUILDERS
MARINE ENGINEERS
AND REPAIRERS
WEST HARTLEPOOL

STK911-0170

Apr 5407

 

STK911-0170



© 2021
Lloyd's Register
Foundation