




S.S. "Emilie" W. Thopl. Report N° 5820

3.2.85
14.3.85
27.2.85
22.5.85

LADIES
DRAWING OFFICE,
NO. OF TRADING.

Scale 1/8" = one foot.

Amended Arrangement of Hatch on Red.
on Quarter Deck only & the Engine & Boiler space shifted 2 ft forward.

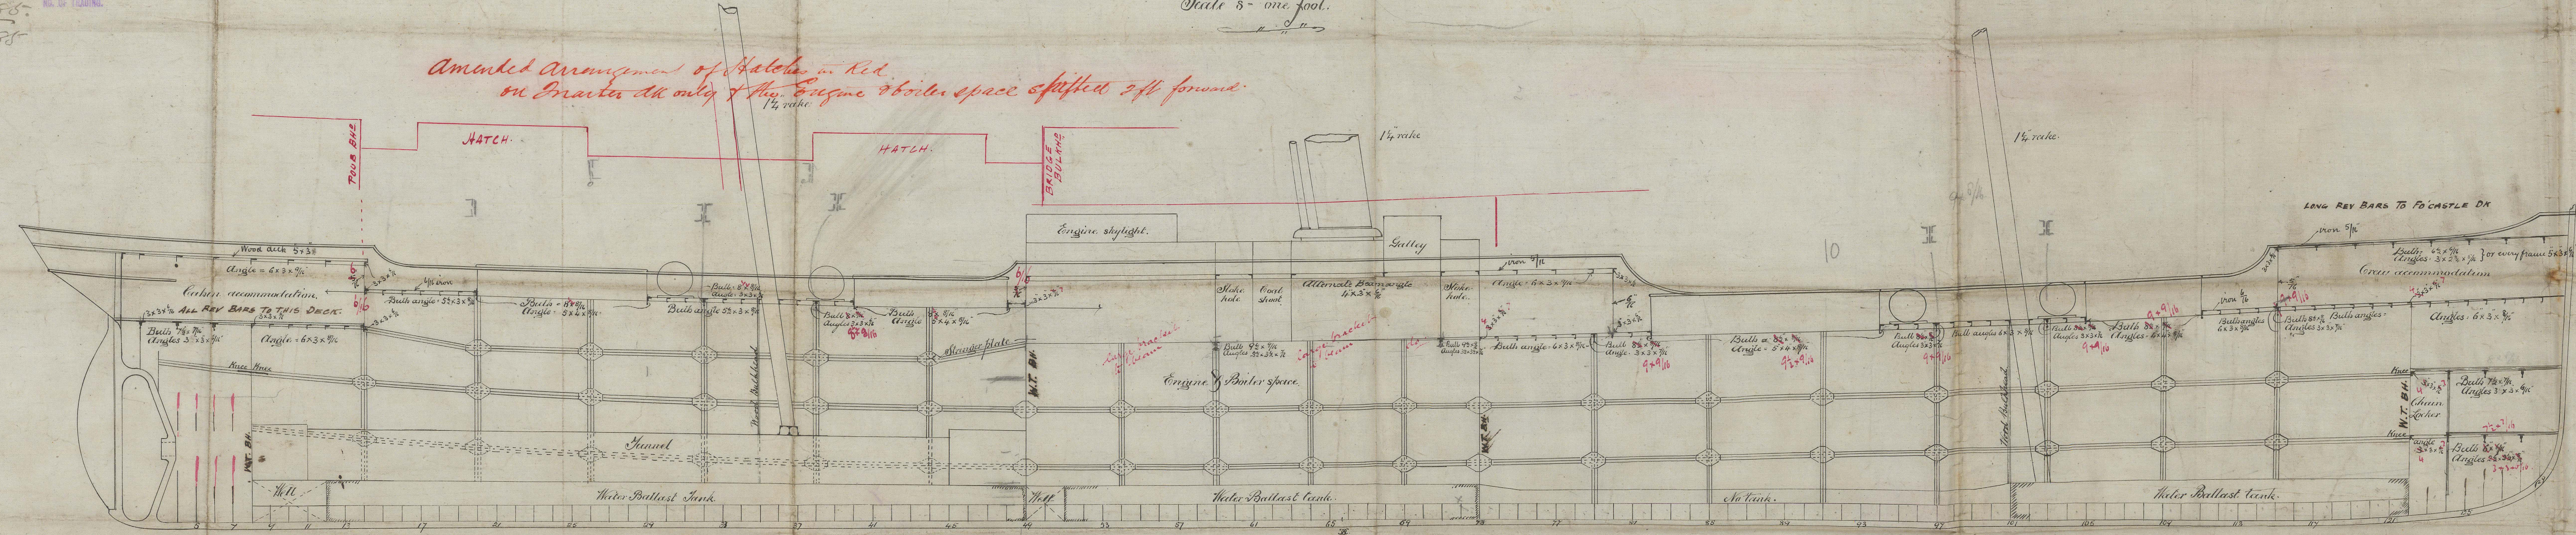

N° 139

N° 139

EDWD. WITBY & CO.
IRON & STEEL SHIP BUILDERS,
SHIP REPAIRERS &,
WEST HARTLEPOOL.

TRACING NO.
14. 24/2/85.

STK912-0074



Lloyd's Register
Foundation