

Received at West Hartlepool Office, 23rd June 1885

Lloyd's Register of British and Foreign Shipping.

(Report on Vessel No. 5820 Port W. Spl.)

No. 240.A SHIP FORGINGS OR CASTINGS.

I have to report that the undermentioned Iron or Steel Forgings or Castings, manufactured by Messrs J Richardson & Sons of Hartlepool for the Vessel No. 139, being built by Messrs E Milby & Co. of Hartlepool have been inspected by me as set forth below, and found to be, so far as can be seen, sound and efficient.

The words FORGINGS or CASTINGS, IRON or STEEL, should be struck out as may be required.


Mark on Forgings.

Lloyd's
No. 240.A
J.R.C.

Bugh Cameron
Sunderland.

	STERN FRAME.	RUDDER FRAME.	STEM.
Material*	<u>Scrap Iron</u>	<u>Scrap Iron</u>	<u>Scrap Iron</u>
How made	<u>Forged</u>	<u>Forged</u>	<u>Forged</u>
Dimensions	<u>8 1/2" x 5'</u>	<u>6 1/4" - 3 1/4'</u>	<u>4 1/2" x 2 7/8'</u>
Progress on Inspection	<u>Forged & Smithed</u>	<u>Forged & Smithed</u>	<u>Forged</u>
Dates when Inspected	<u>March 12-18-20-24 24</u> <u>April 10-14/85</u>	<u>May 4-6-8-12-15-18 22</u> <u>June 8/85</u>	<u>March 9/85</u>

SKETCHES OF FRAMES SHEWING POSITION AND DESCRIPTION OF WELDS OF FORGINGS, OR PARTICULARS OF TESTS APPLIED TO CASTINGS.

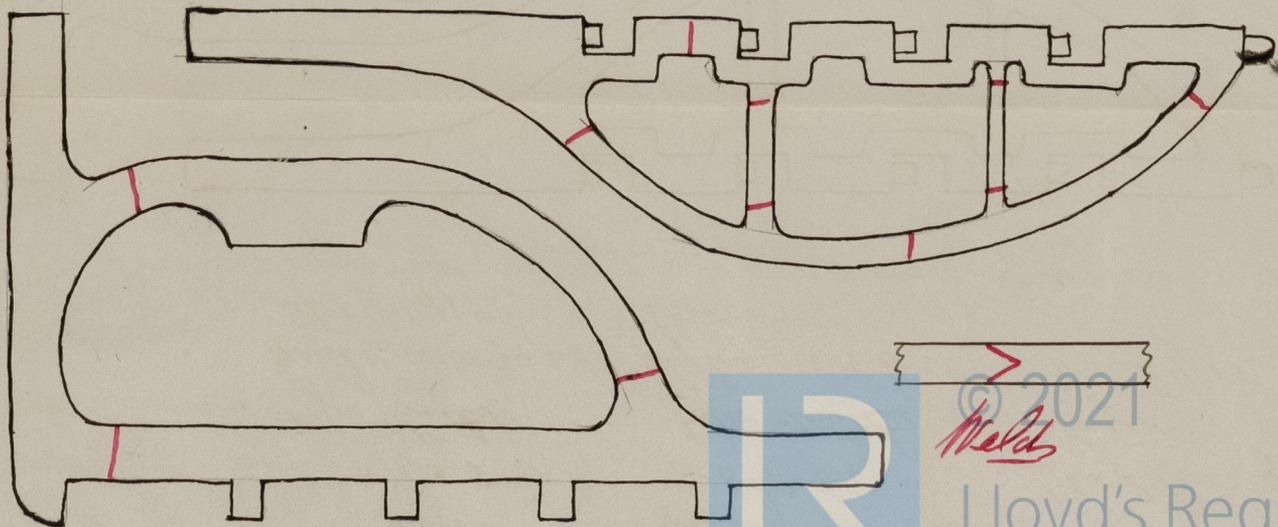

© 2021
Welds

Lloyd's Register
Foundation

* If of Iron, state whether scrap or puddled Iron.