



2.5.85
4.14.85
20.4.85
13.5.85

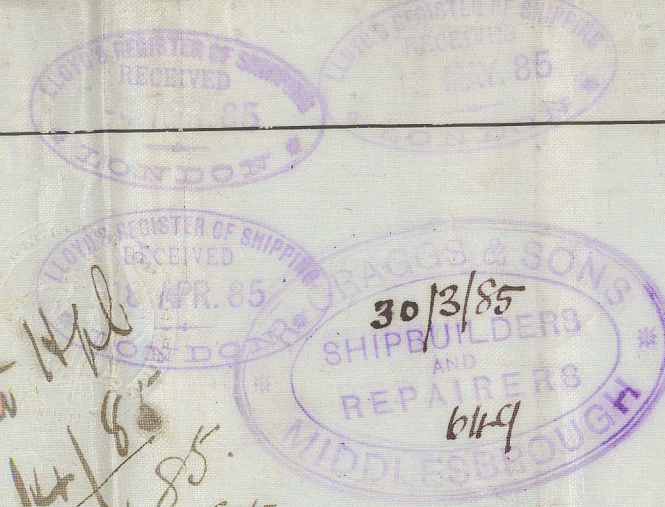

S.S. Sir Robert Peel M. S. R. Report No. 5880

ELEVATION
No 39 SS

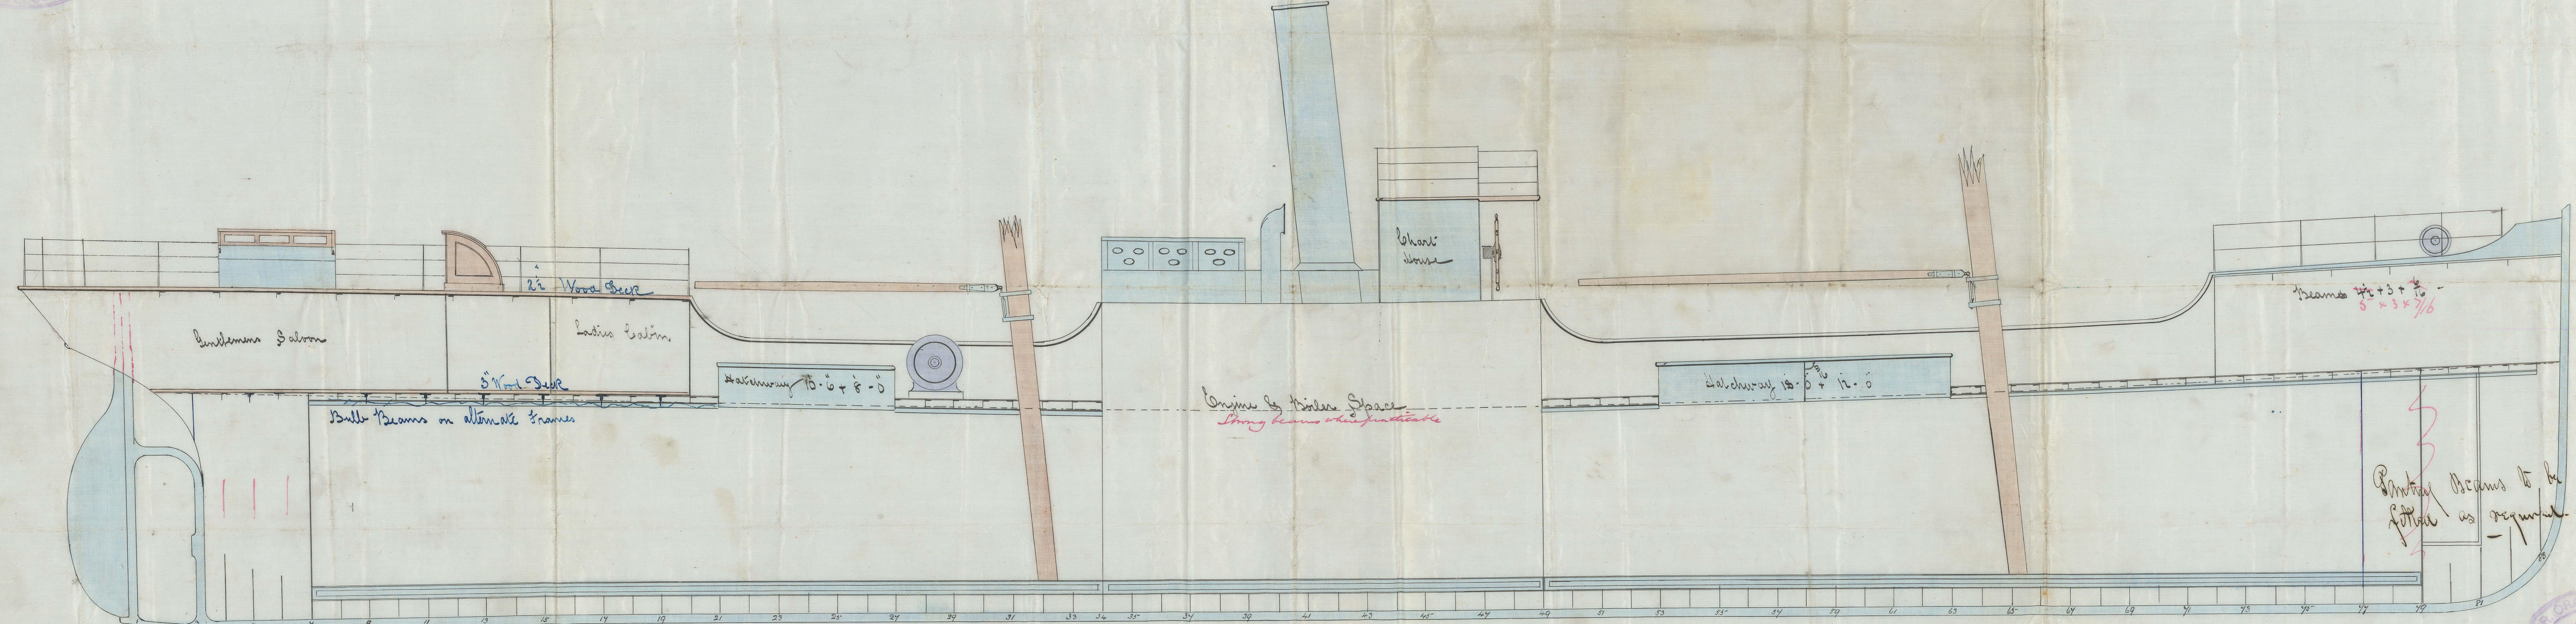

SCALE 1/4 INCH TO ONE FOOT

Boat House
Beams to be
fitted as required



1/11/85

1/11/85



© 2021
Lloyd's Register
Foundation