

Lloyd's Register of British and Foreign Shipping.

The words FORGINGS or CASTINGS, IRON or STEEL, should be struck out as may be required.

Sir Robert Peel (Report on Vessel No. *5850* Port *W. Dept.*)

No. *288.a* SHIP FORGINGS OR CASTINGS.

I have to report that the undermentioned Iron or ~~Steel~~ Forgings or Castings, manufactured by *Messrs C H Reed & Co Ltd* of *Sunderland* for the Vessel No. *39*, being built by *Messrs R Cropper & Sons* of *Middlesbrough* have been inspected by me as set forth below, and found to be, so far as can be seen, *sound*.


Mark on Forgings.

Lloyd's
No. *288.a*
H.C.

Hugh Cameron
Sunderland.

| | STERN FRAME. | RUDDER FRAME. | STEM. |
|------------------------|--|--|------------------------|
| Material* | <i>Scrap Iron</i> | <i>Scrap Iron</i> | <i>Scrap Iron</i> |
| How made | <i>Faged</i> | <i>Faged</i> | <i>Faged</i> |
| Dimensions | <i>6 3/4" x 3 1/4"</i> | <i>3 3/4" - 2 1/4"</i> | <i>6 3/4" x 1 1/2"</i> |
| Progress on Inspection | <i>Faged Smithed</i> | <i>Faged Smithed</i> | <i>Faged</i> |
| Dates when Inspected | <i>April 18-22-28</i> <i>May 1-11-13/85</i> | <i>May 19-28 June 3-10</i> <i>15-20-25/85</i> | <i>April 28/85</i> |

SKETCHES OF FRAMES SHEWING POSITION AND DESCRIPTION OF WELDS OF FORGINGS, OR PARTICULARS OF TESTS APPLIED TO CASTINGS.

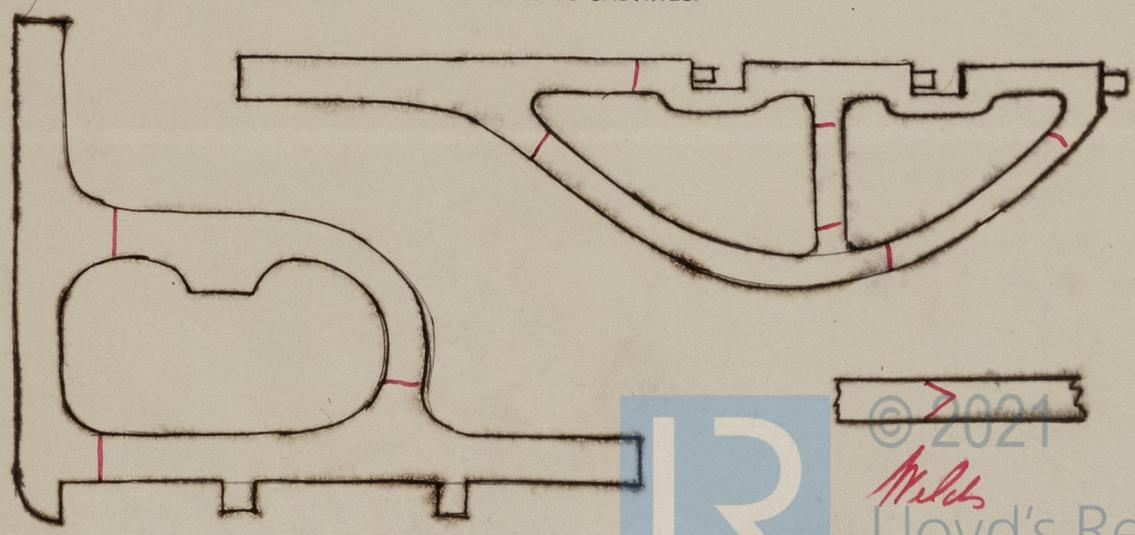

© 2021
Mills
Lloyd's Register
Foundation

* If of Iron, state whether scrap or puddled Iron.

288